



SCALE
4" = 1 mile

NORTH

Monner Spring

T 11 S., R 14 E. Sec 2.

SW, NE.

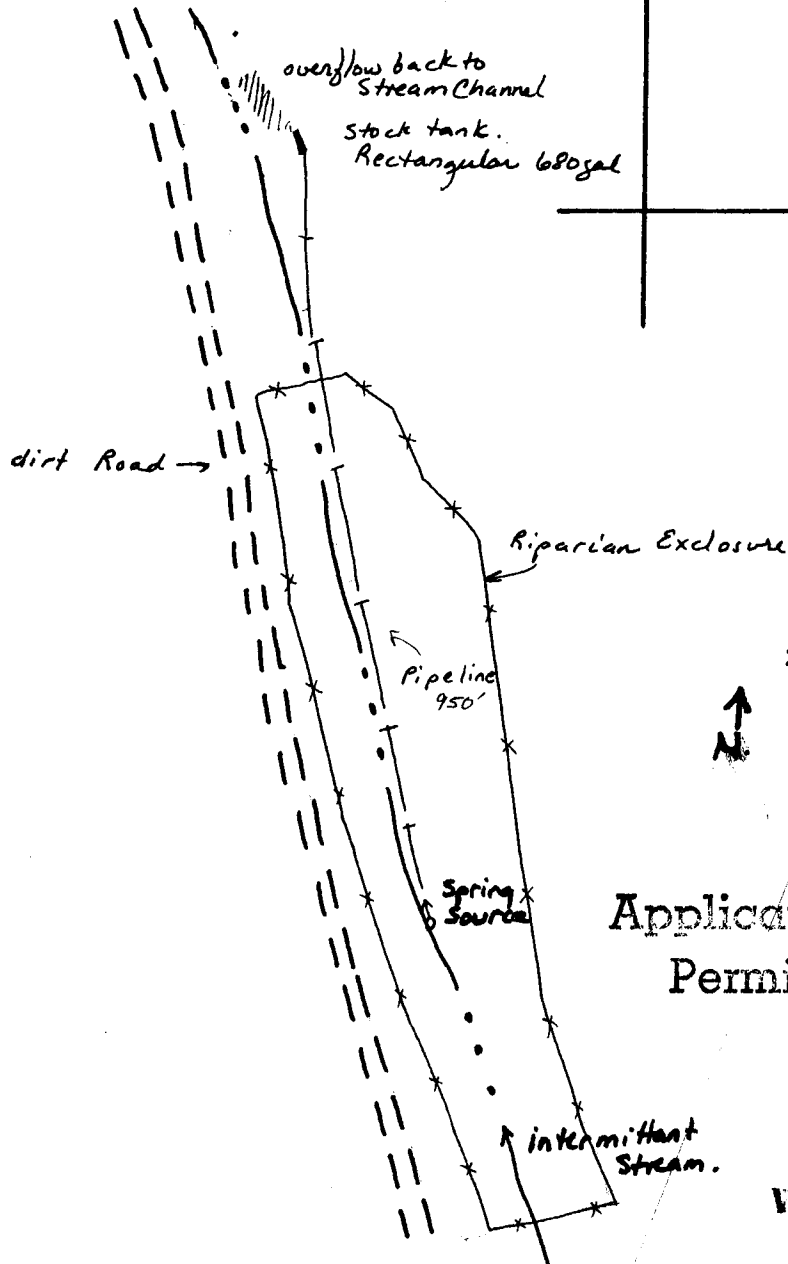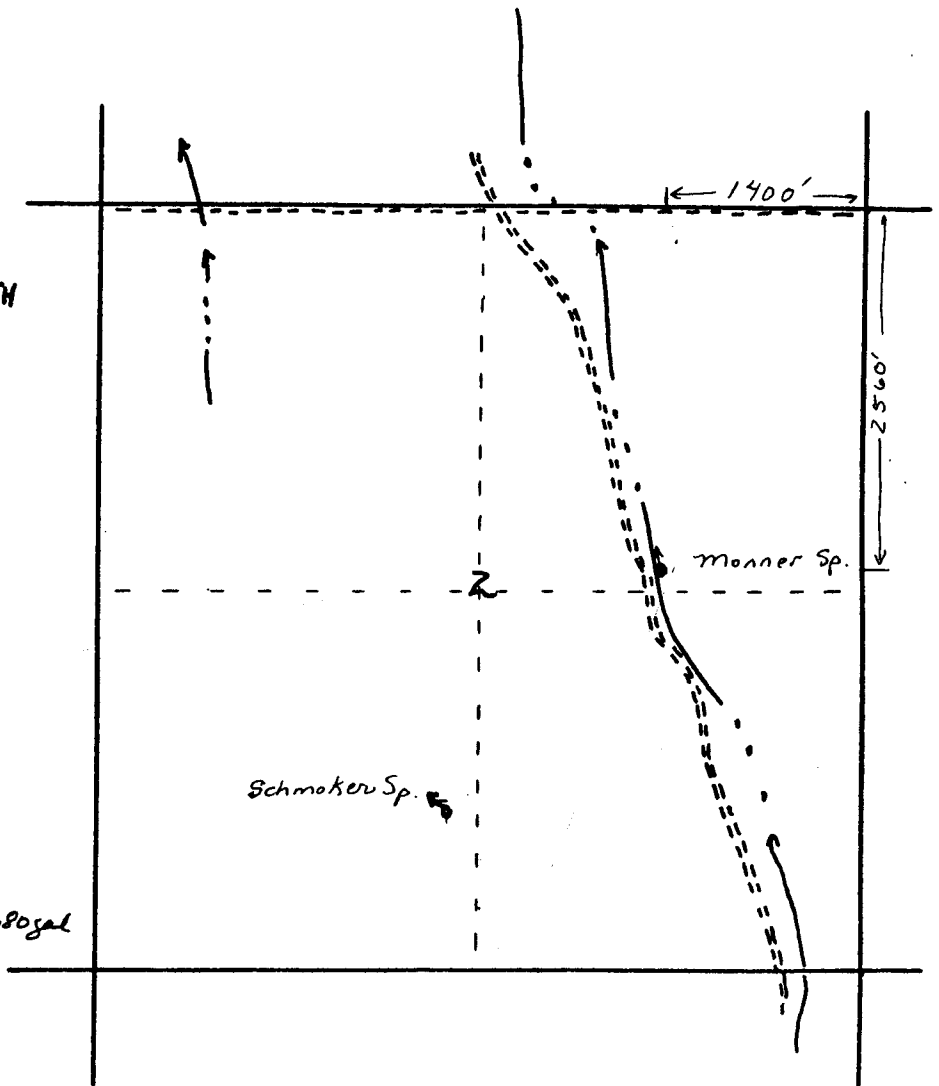

Sketch Diagram of Development



$\frac{1}{2}'' = 100'$

Application No. 66368

Permit No. 52362

RECEIVED

SEP 19 1983

WATER RESOURCES DEPT.
SALEM, OREGON