

Application No. 66369
Permit No. 52361


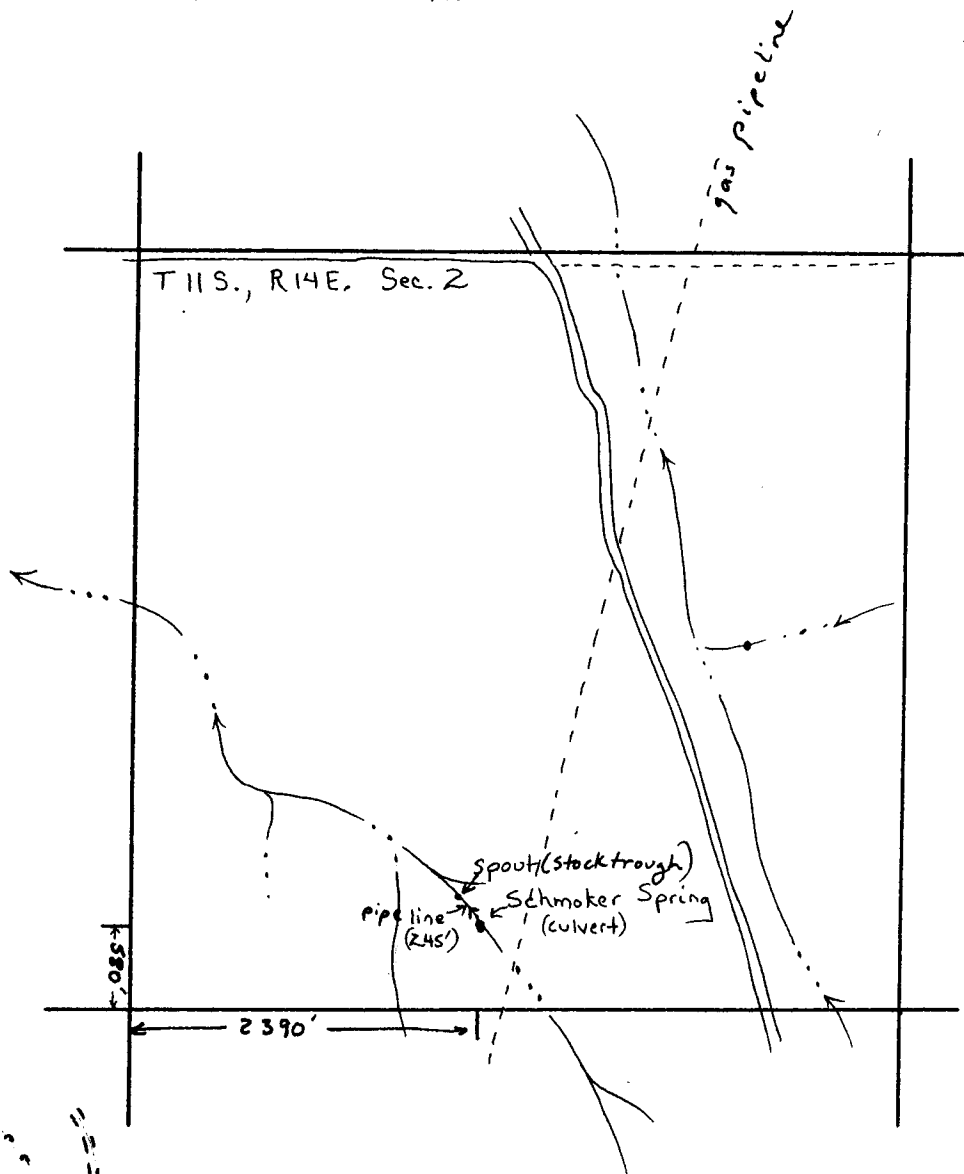


Diagram
1" = 100'



1983 redevelopment SCALE
425' of white PVC 4" = 1 MILE
(1 1/4 inch) to one 4' x 14' x 18"
Rectangular trough

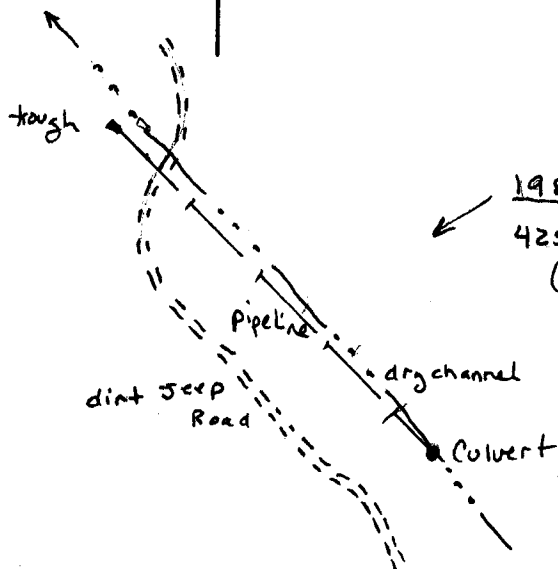

RECEIVED

SEP 19 1983
WATER RESOURCES DEPT.
SALEM, OREGON