


PARKEY SPRING T. 11 S., R. 14 E., Sec 10, SE, SE.

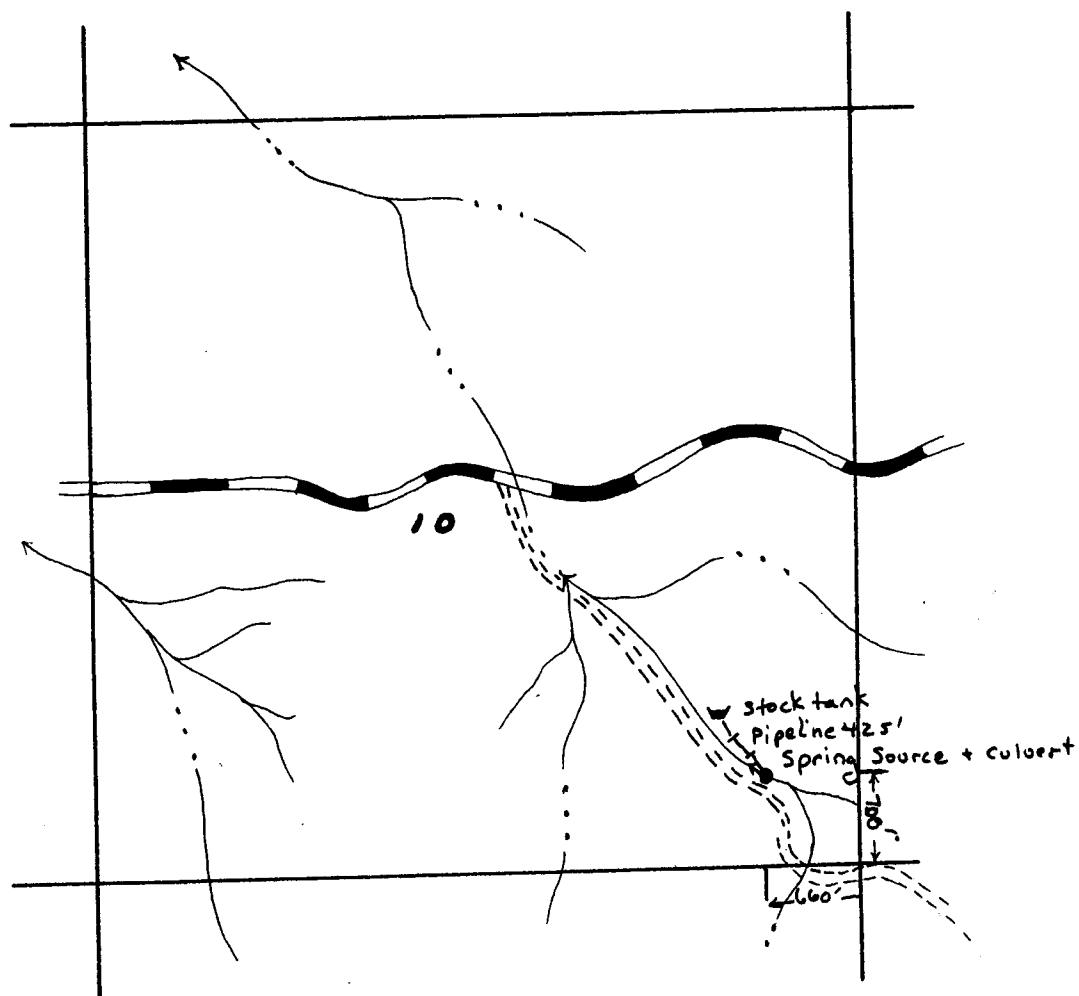

Application No.
Permit No.

66370

52360

SCALE
4" = 1 MILE

↑
NORTH

Topographic map of the Parkey Spring area in Oregon. The map features contour lines indicating elevation, with labels such as 2700, 2800, 2900, 3000, and 3100. Key landmarks include Parkey Spring, Schmoker Spring, and Buck Butte. A road is shown running horizontally across the middle, with a section labeled 'ROAD' and another 'JEEP'. A pipeline is marked with a dashed line and labeled 'PIPELINE'. A trail is indicated by a dashed line and labeled 'TRAIL'. The map includes a scale bar for 1 mile and a north arrow. Handwritten notes include 'c. 10 1/4, SE 1/4' and '3/77'. A date stamp 'SEP 9 1983' and 'SALEM, OREGON' are visible. Elevation points are marked with 'x' and values like 2778, 2920, 2712, 2809, 3055, and 2967.

1 H
T
R
O
N

PIPELINE

66370

52360

SEP 9 1983

SALEM, OREGON

Buck Butte

3107

3055