

SCALE
4" = 1 mile

NORTH

Juniper Spring

T. 12 S., R. 14 E. Section 9

NE, NE

Application No.

66371

Permit No.

52359


WATER RESOURCES DEPT.
SALEM, OREGON



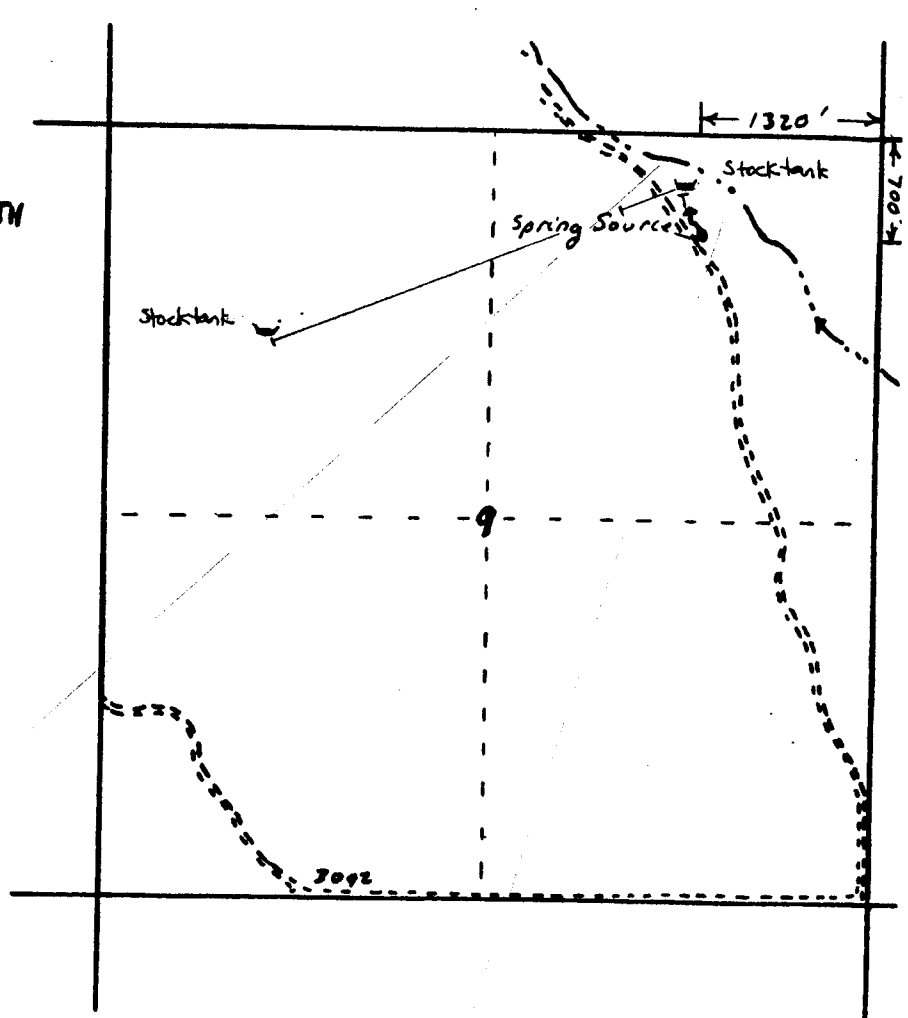


Diagram of Development.

N 1" = 100'

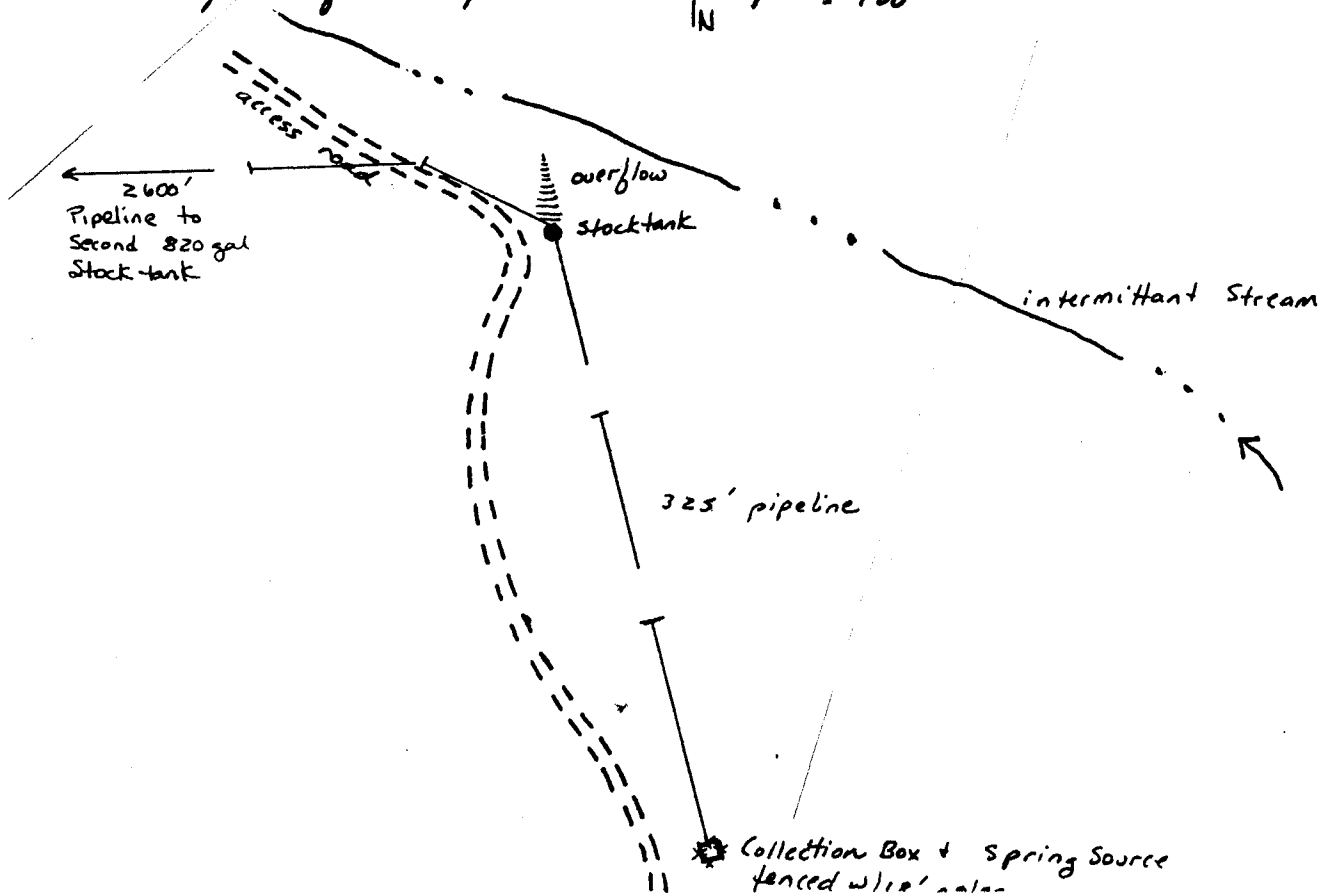

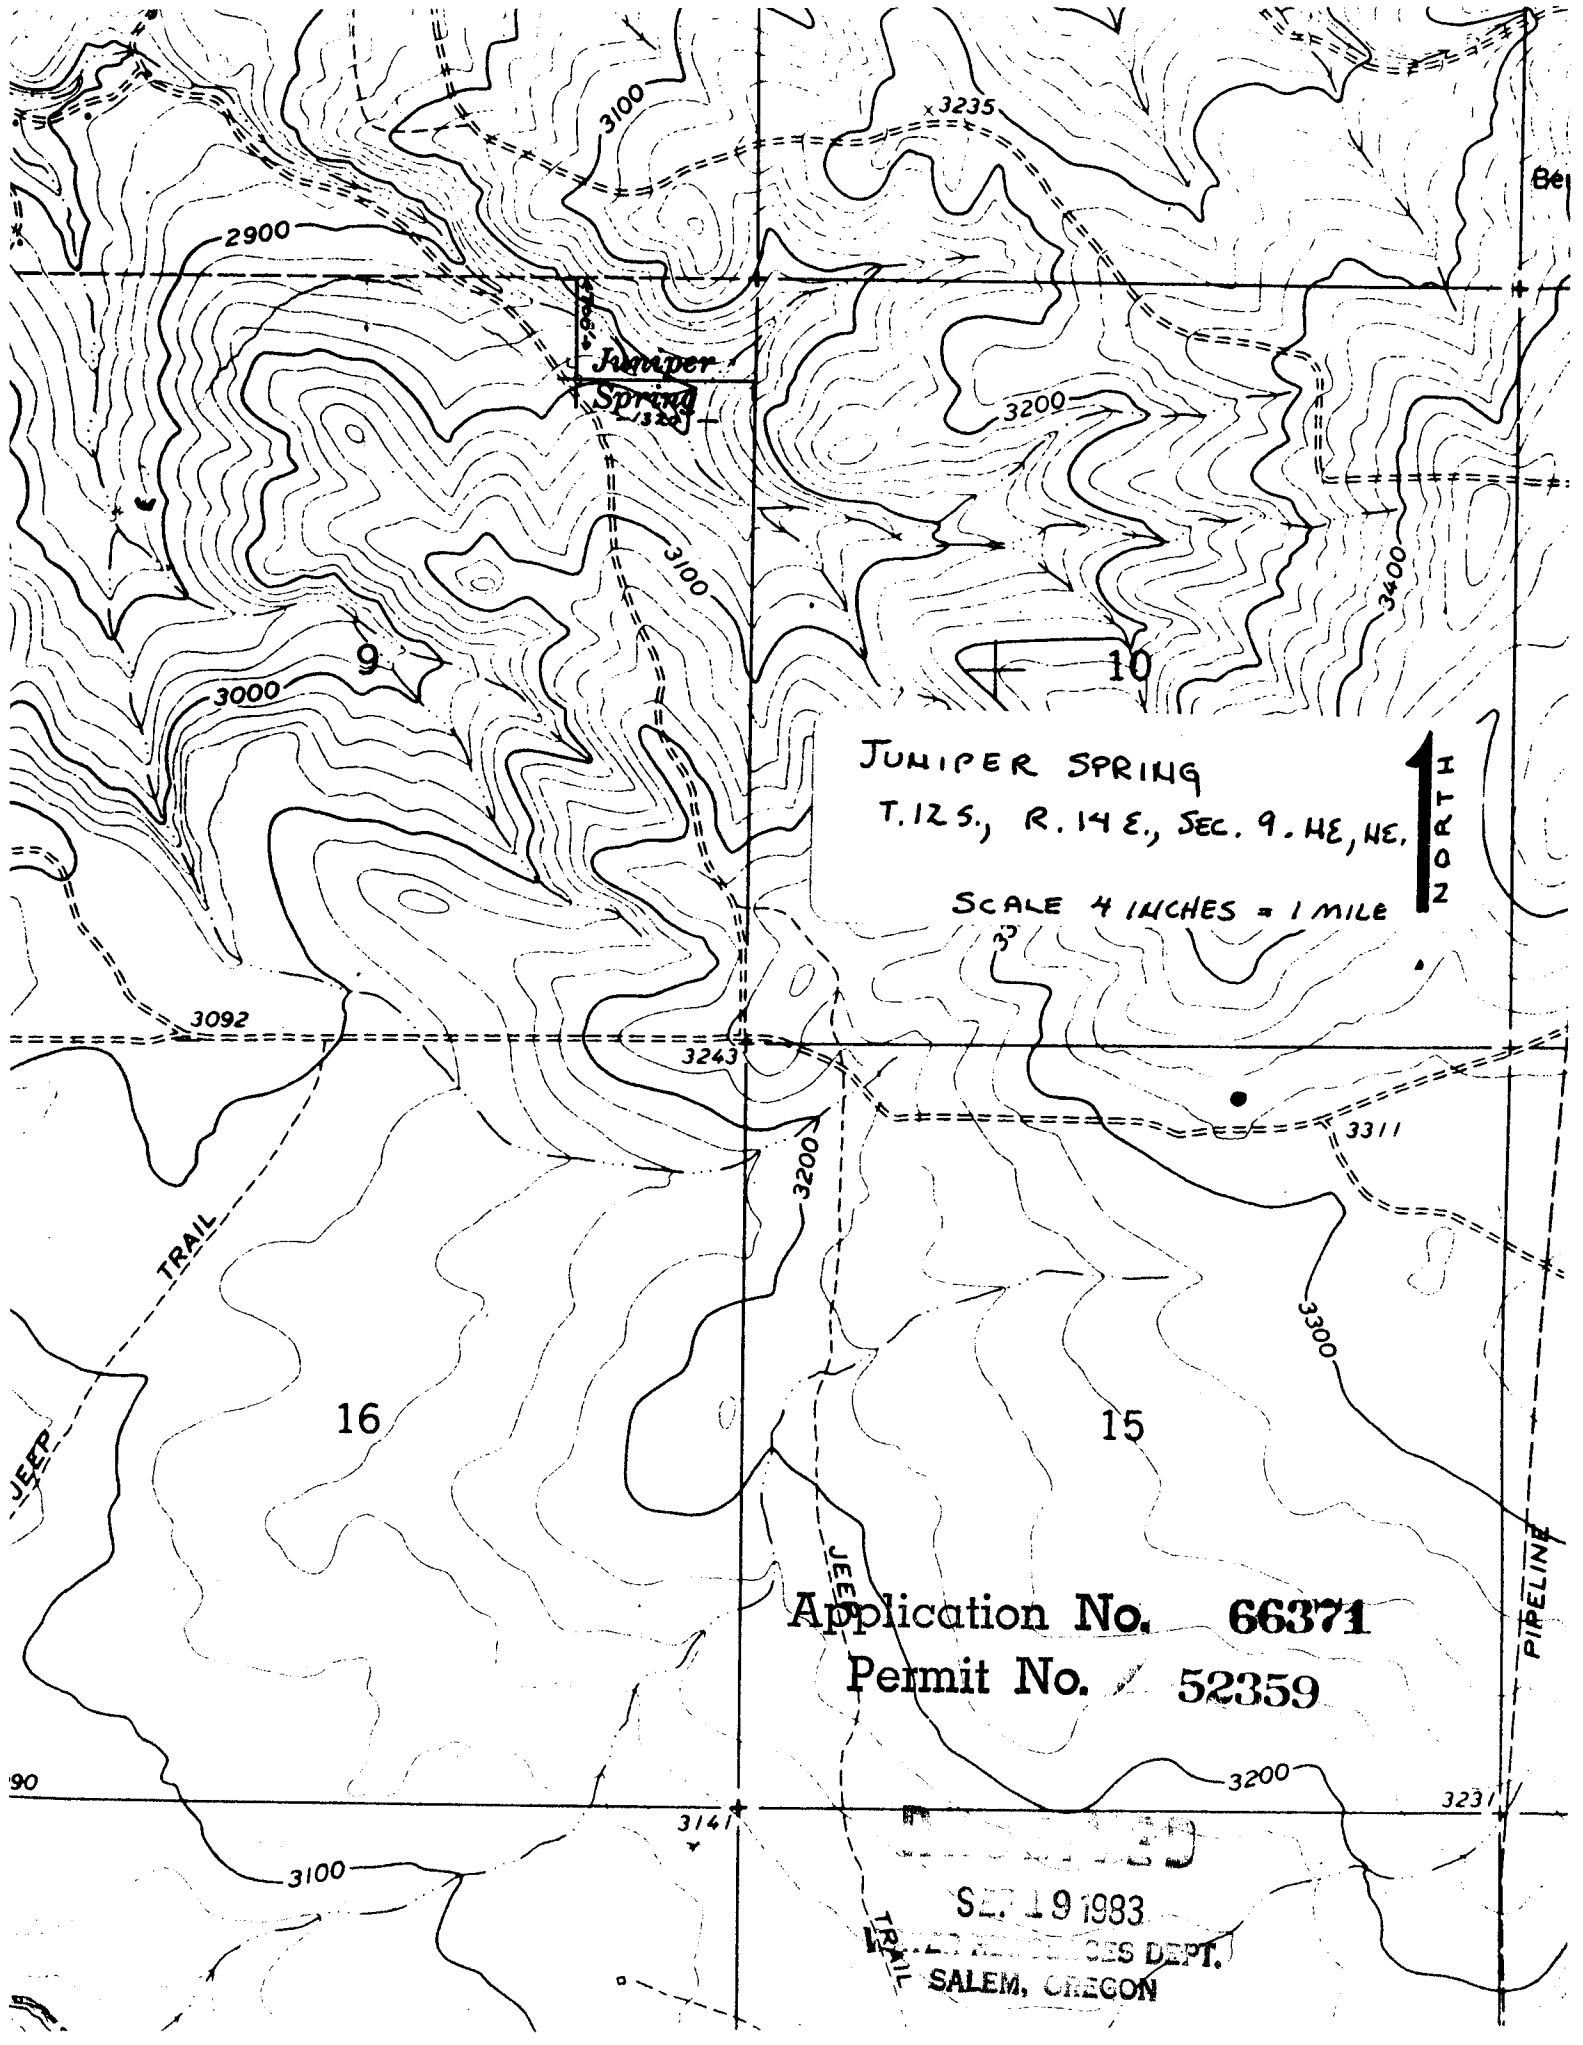

JUNIPER SPRING
T. 12 S., R. 14 E., SEC. 9. NE, NE.

SCALE 4 INCHES = 1 MILE

1
T
R
O
2

Application No. 66371
Permit No. 52359

RECEIVED
SEP 19 1983
SALEM, OREGON