

SCALE
4" = 1 mile

NORTH

Lower Bennett Spring

T. 11 S., R. 14 E., Sec 34
SW, SW.

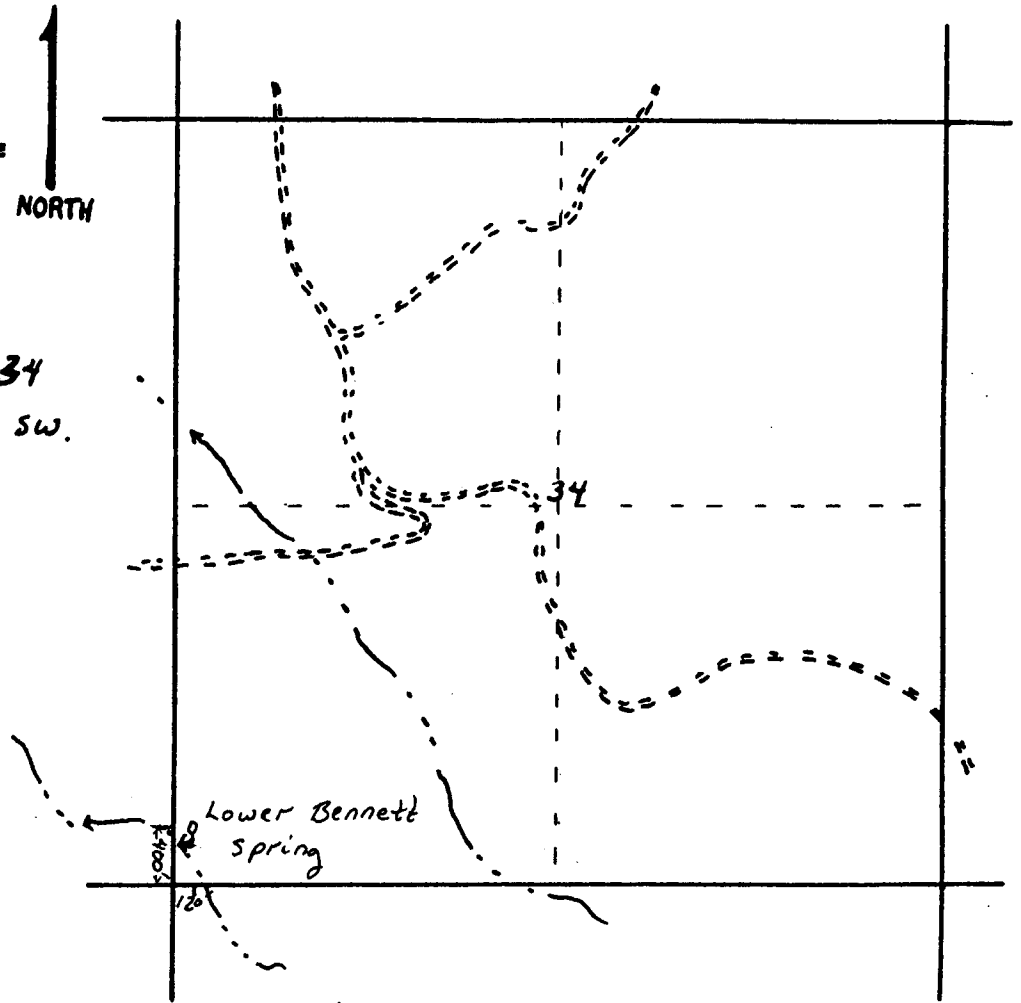


Diagram of Development


1" = 50'

N

Application No.

66372

Permit No. 52401

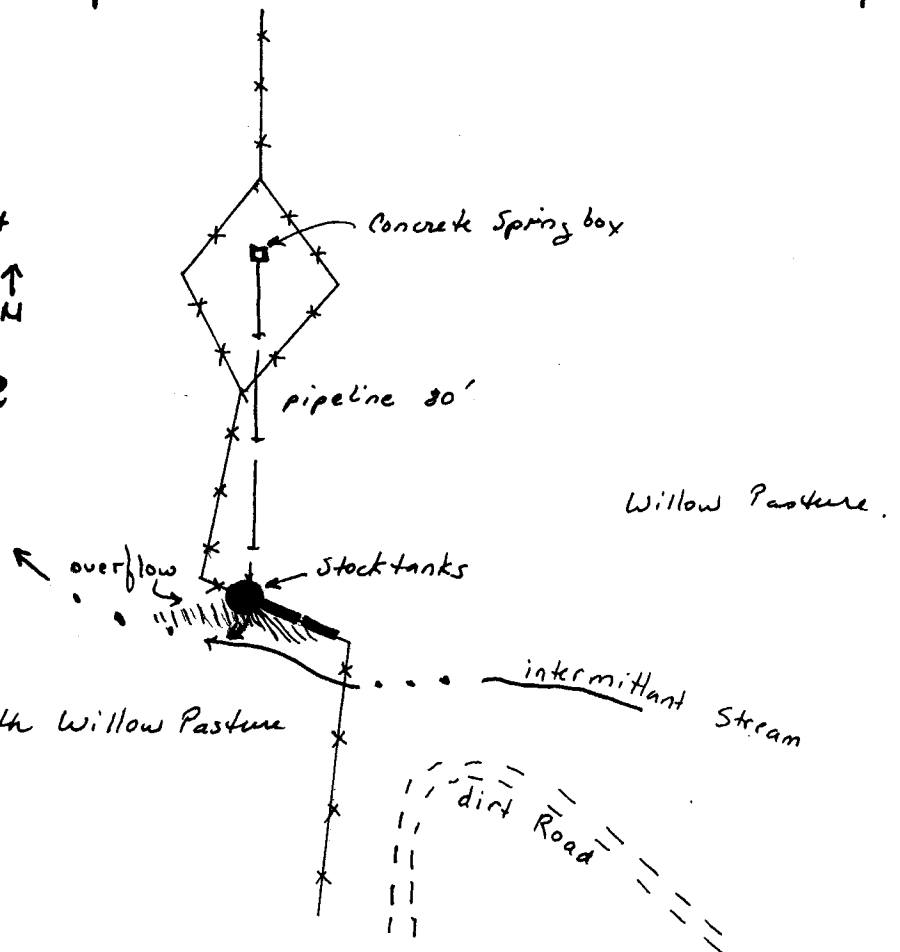

RECEIVED
SEP 19 1983
SALEM, OREGON

Well
#2775

ROAD

Suicide
Well

3088

3341

3100

North Combs
Spring

LOWER BENNETT SPRING

T. 11 S., R. 14 E., SEC 34, SW, SW

SCALE 4 INCHES = 1 MILE

South
Combs Spring

Lower Bennett
Spring

2868

3259

Upper Bennett
Spring

Reuter
Well

82.19.1983

WATER RESOURCES DEPT.
SALEM, OREGON

Larson
Spring

Bennett Well

Application No. 66372

Permit No. 52401

Juniper
Spring

1
T
R
O
N

PIPELINE

GRIZZLY