


SCALE
4" = 1 mile

NORTH

North Combs Spring +
South Combs Spring

T. 11 S., R. 14 E.

Section 34 NE, SW.

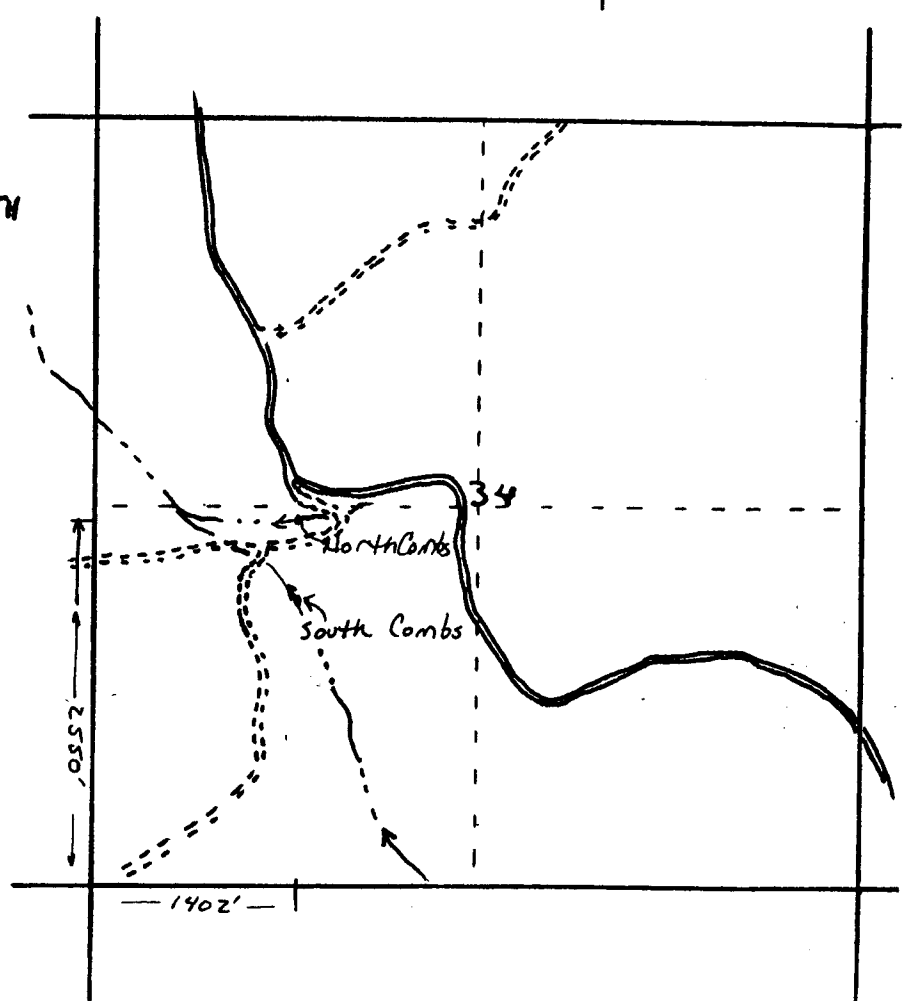

RECEIVED


SEP 19 1983
WATER RESOURCES DEPT.
SALEM, OREGON

Application No. 66373
Permit No. 52358

North Combs - South Combs Springs.

Sketch Diagram of Development

1" = 100' ↑N

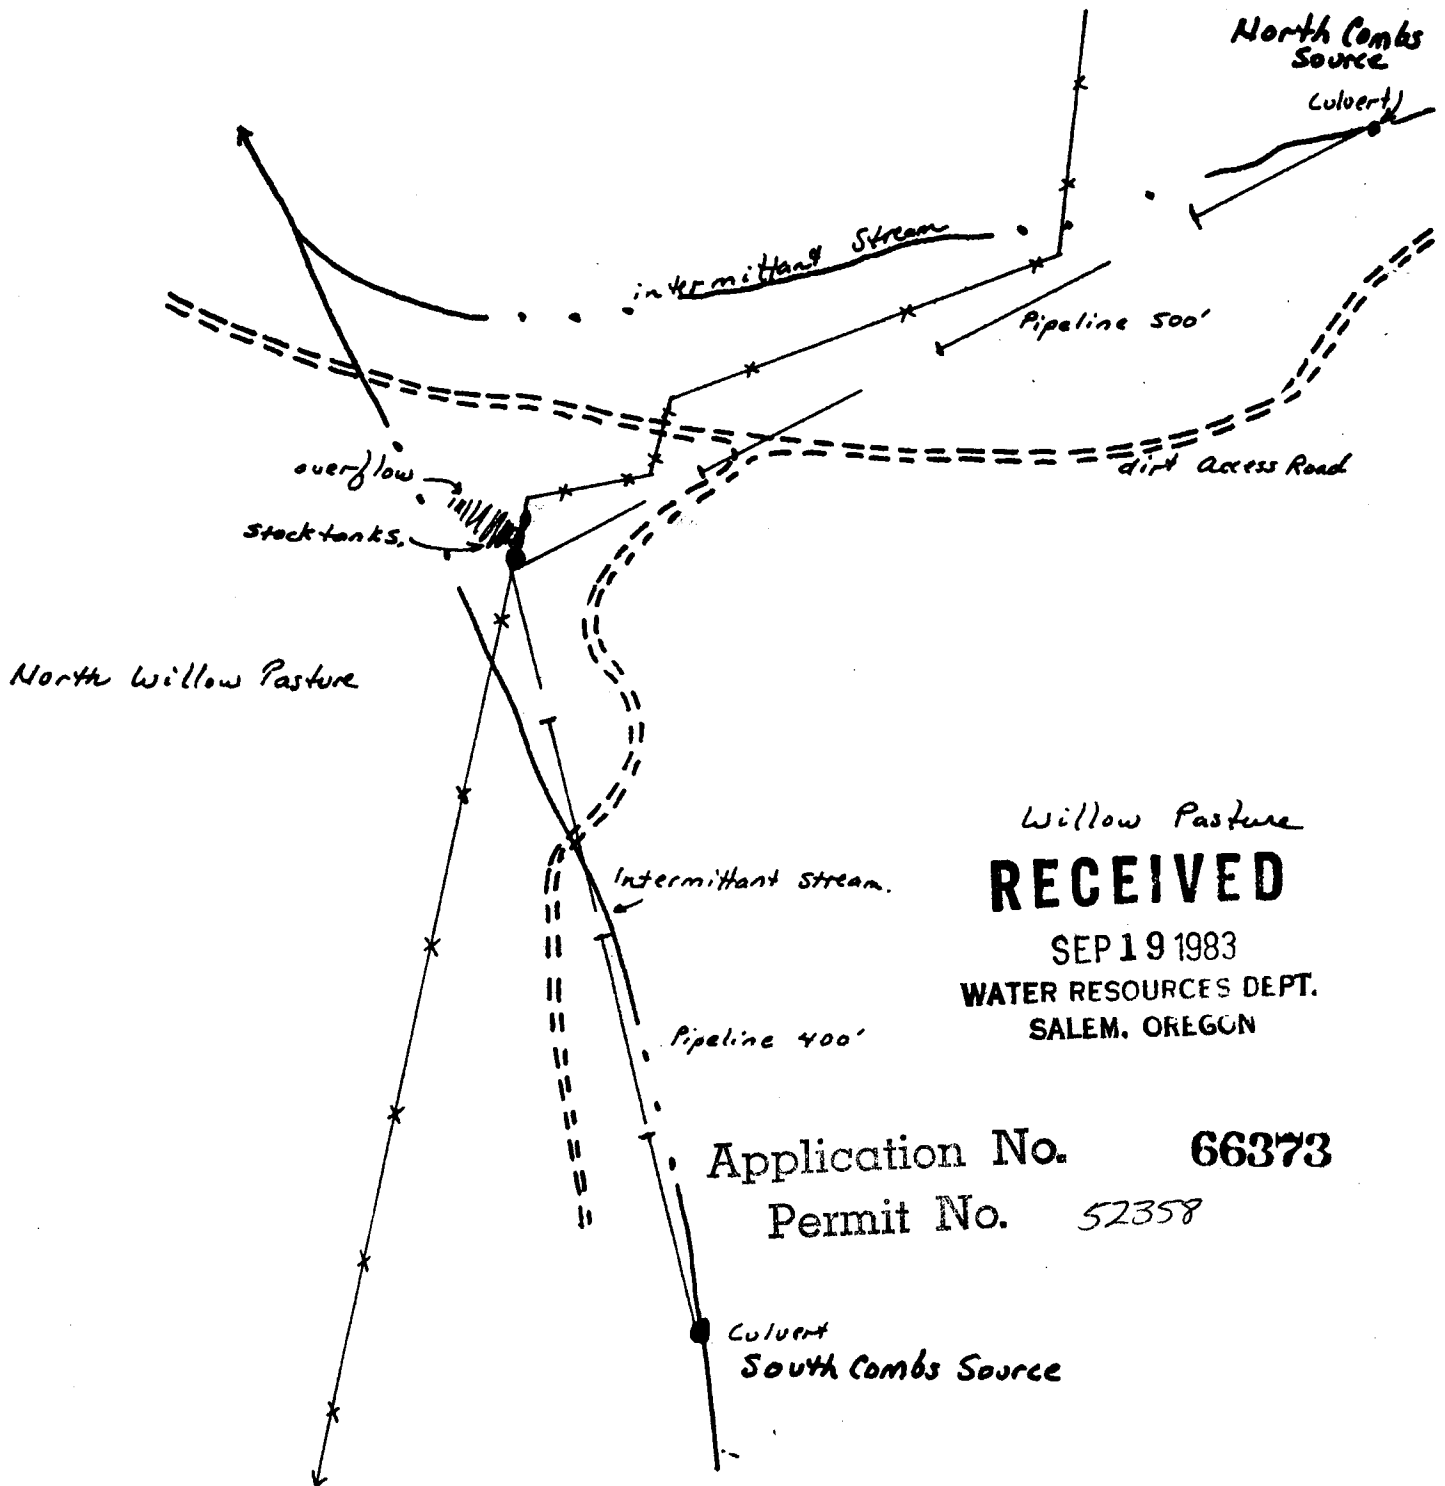

Well
2775

Map 30A4

ROAD

Suicide
Well

3088

3341

North Combs
Spring

NORTH COMBS SPRING
T.11.S., R.14.E., SEC 34

1
T
R
O
N

SCALE 4 INCHES = 1 MILE

PIPELINE

Lower Bennett
Spring

2868

3259

Upper Bennett
Spring

RECEIVED

SEP 19 1983

WATER RESOURCES DEPT.
SALEM, OREGON

Reuter
Well

Larson
Spring

Application No.
Permit No.

66373


Bennett Well

Juniper
Spring

GRIZZLY
3400

Well
#2775

Map 4 of 4

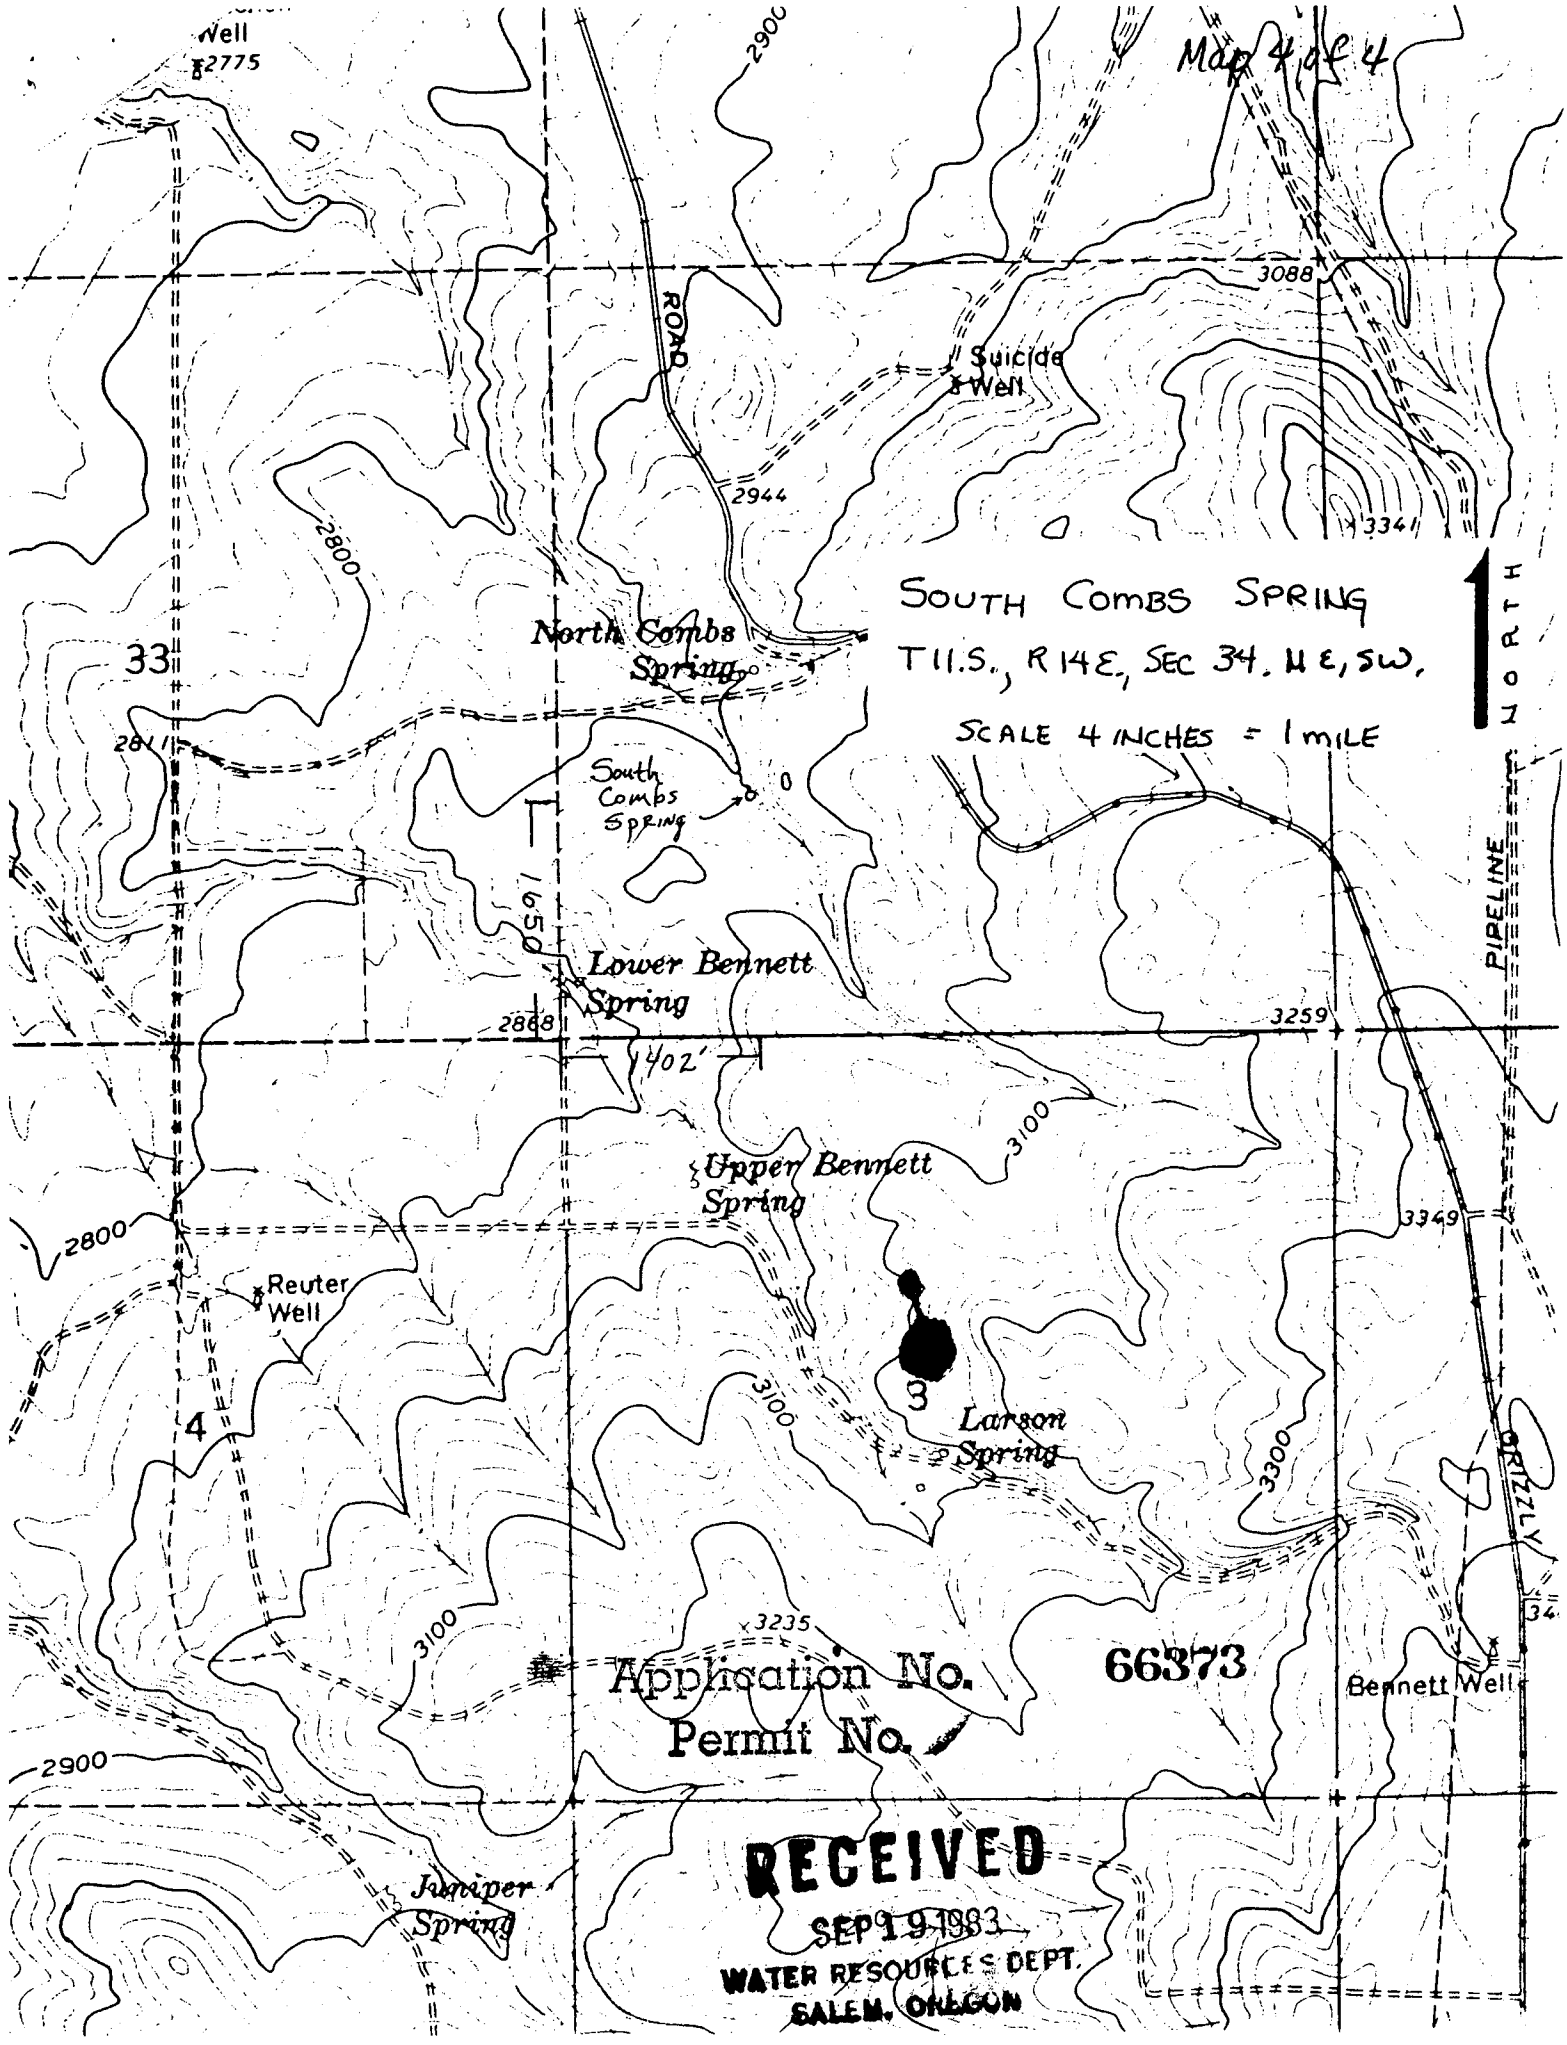

SOUTH COMBS SPRING
T11.S., R14E., SEC 34. NE, SW.

SCALE 4 INCHES = 1 MILE

Application No. 66373
Permit No.

RECEIVED
SEP 19 1983
WATER RESOURCES DEPT.
SALEM, OREGON