


↑ NORTH
4" = 1 mile

Mud Springs.

T. 11. S., R. 14 E., Section 21

Pipelines, Storage tank & troughs

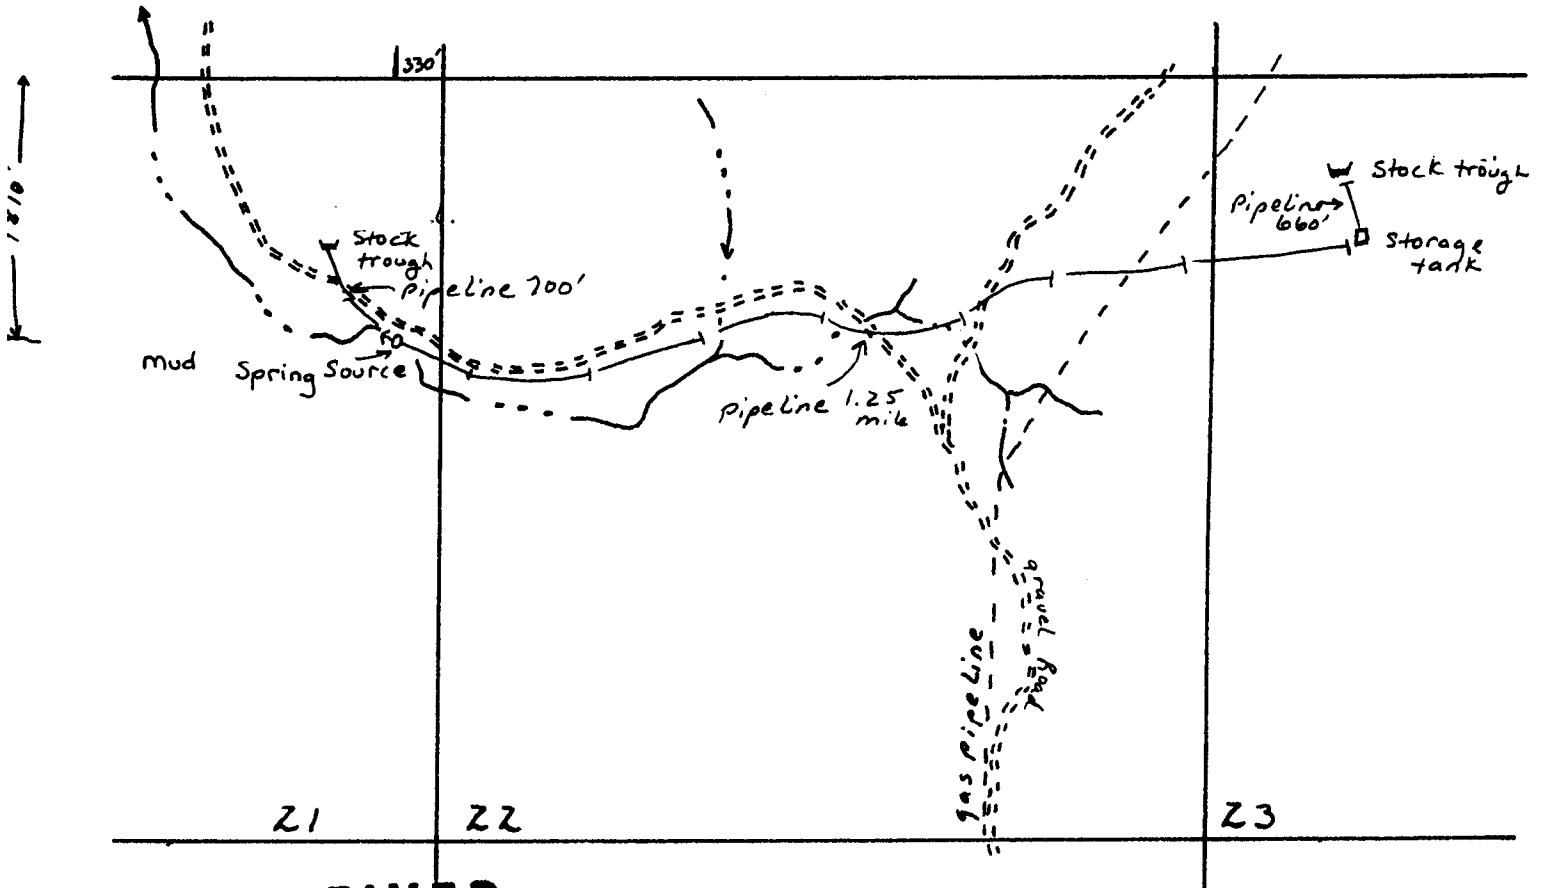


RECEIVED


SEP 19 1983
WATER RESOURCES DEPT.
SALEM, OREGON

Application No. 66374

Permit No. 52357

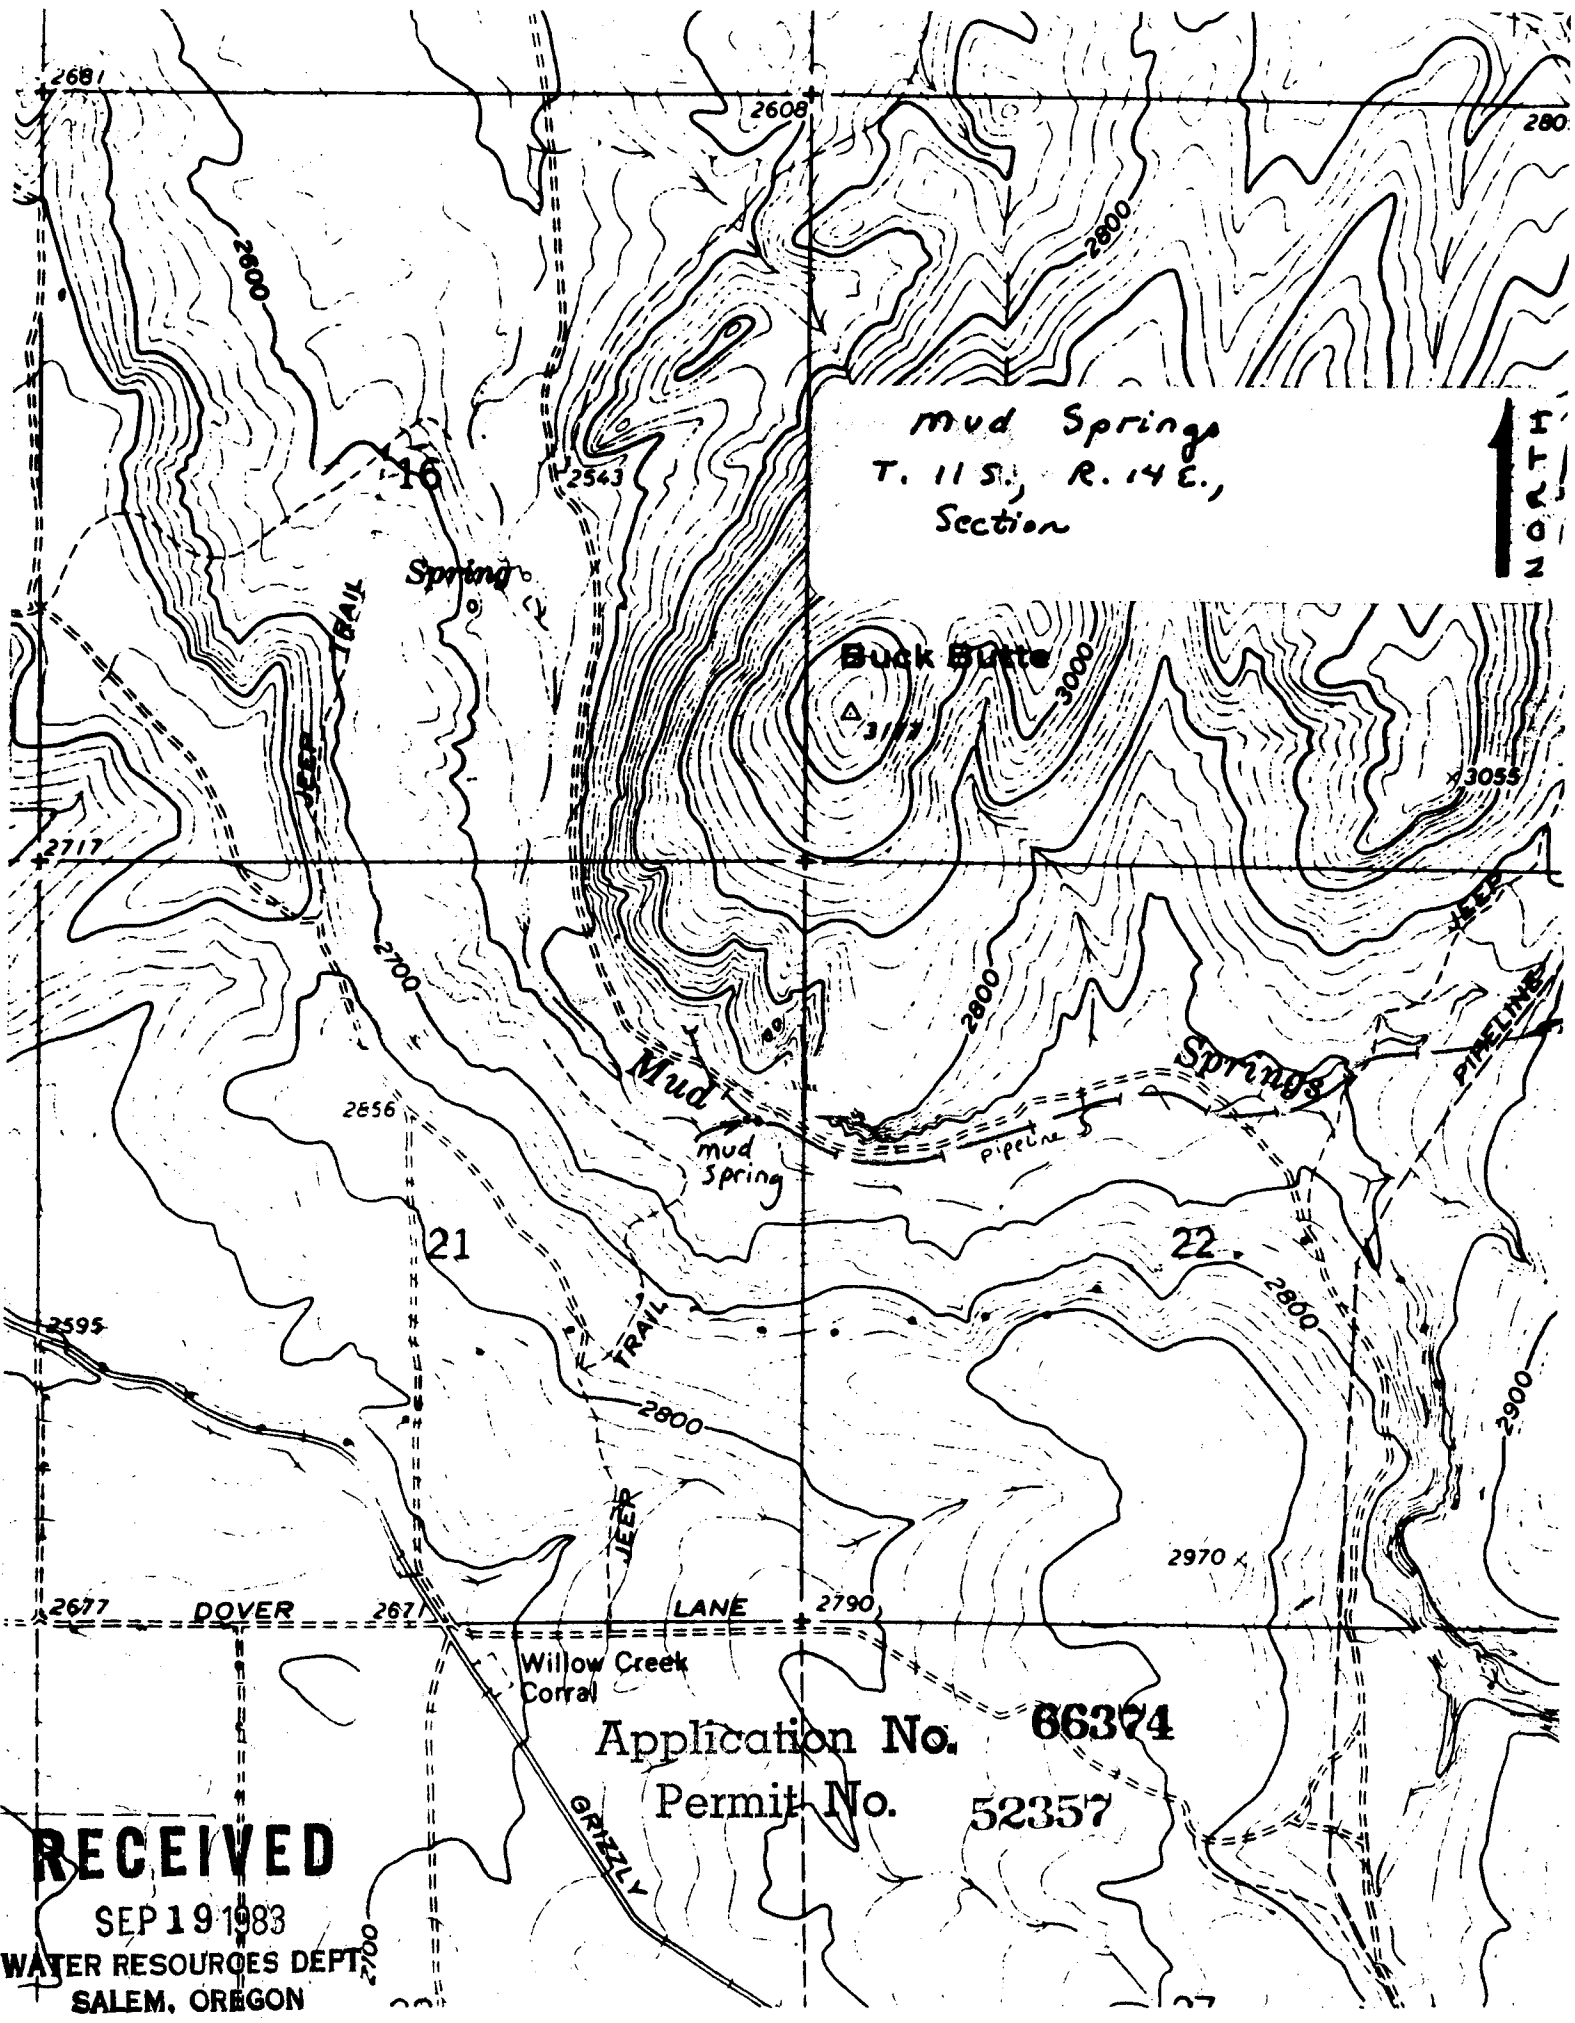

Mud Springs
T. 11 S., R. 14 E.,
Section

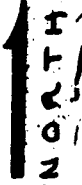

Application No. 66374
Permit No. 52357

RECEIVED

SEP 19 1983
WATER RESOURCES DEPT.
SALEM, OREGON