


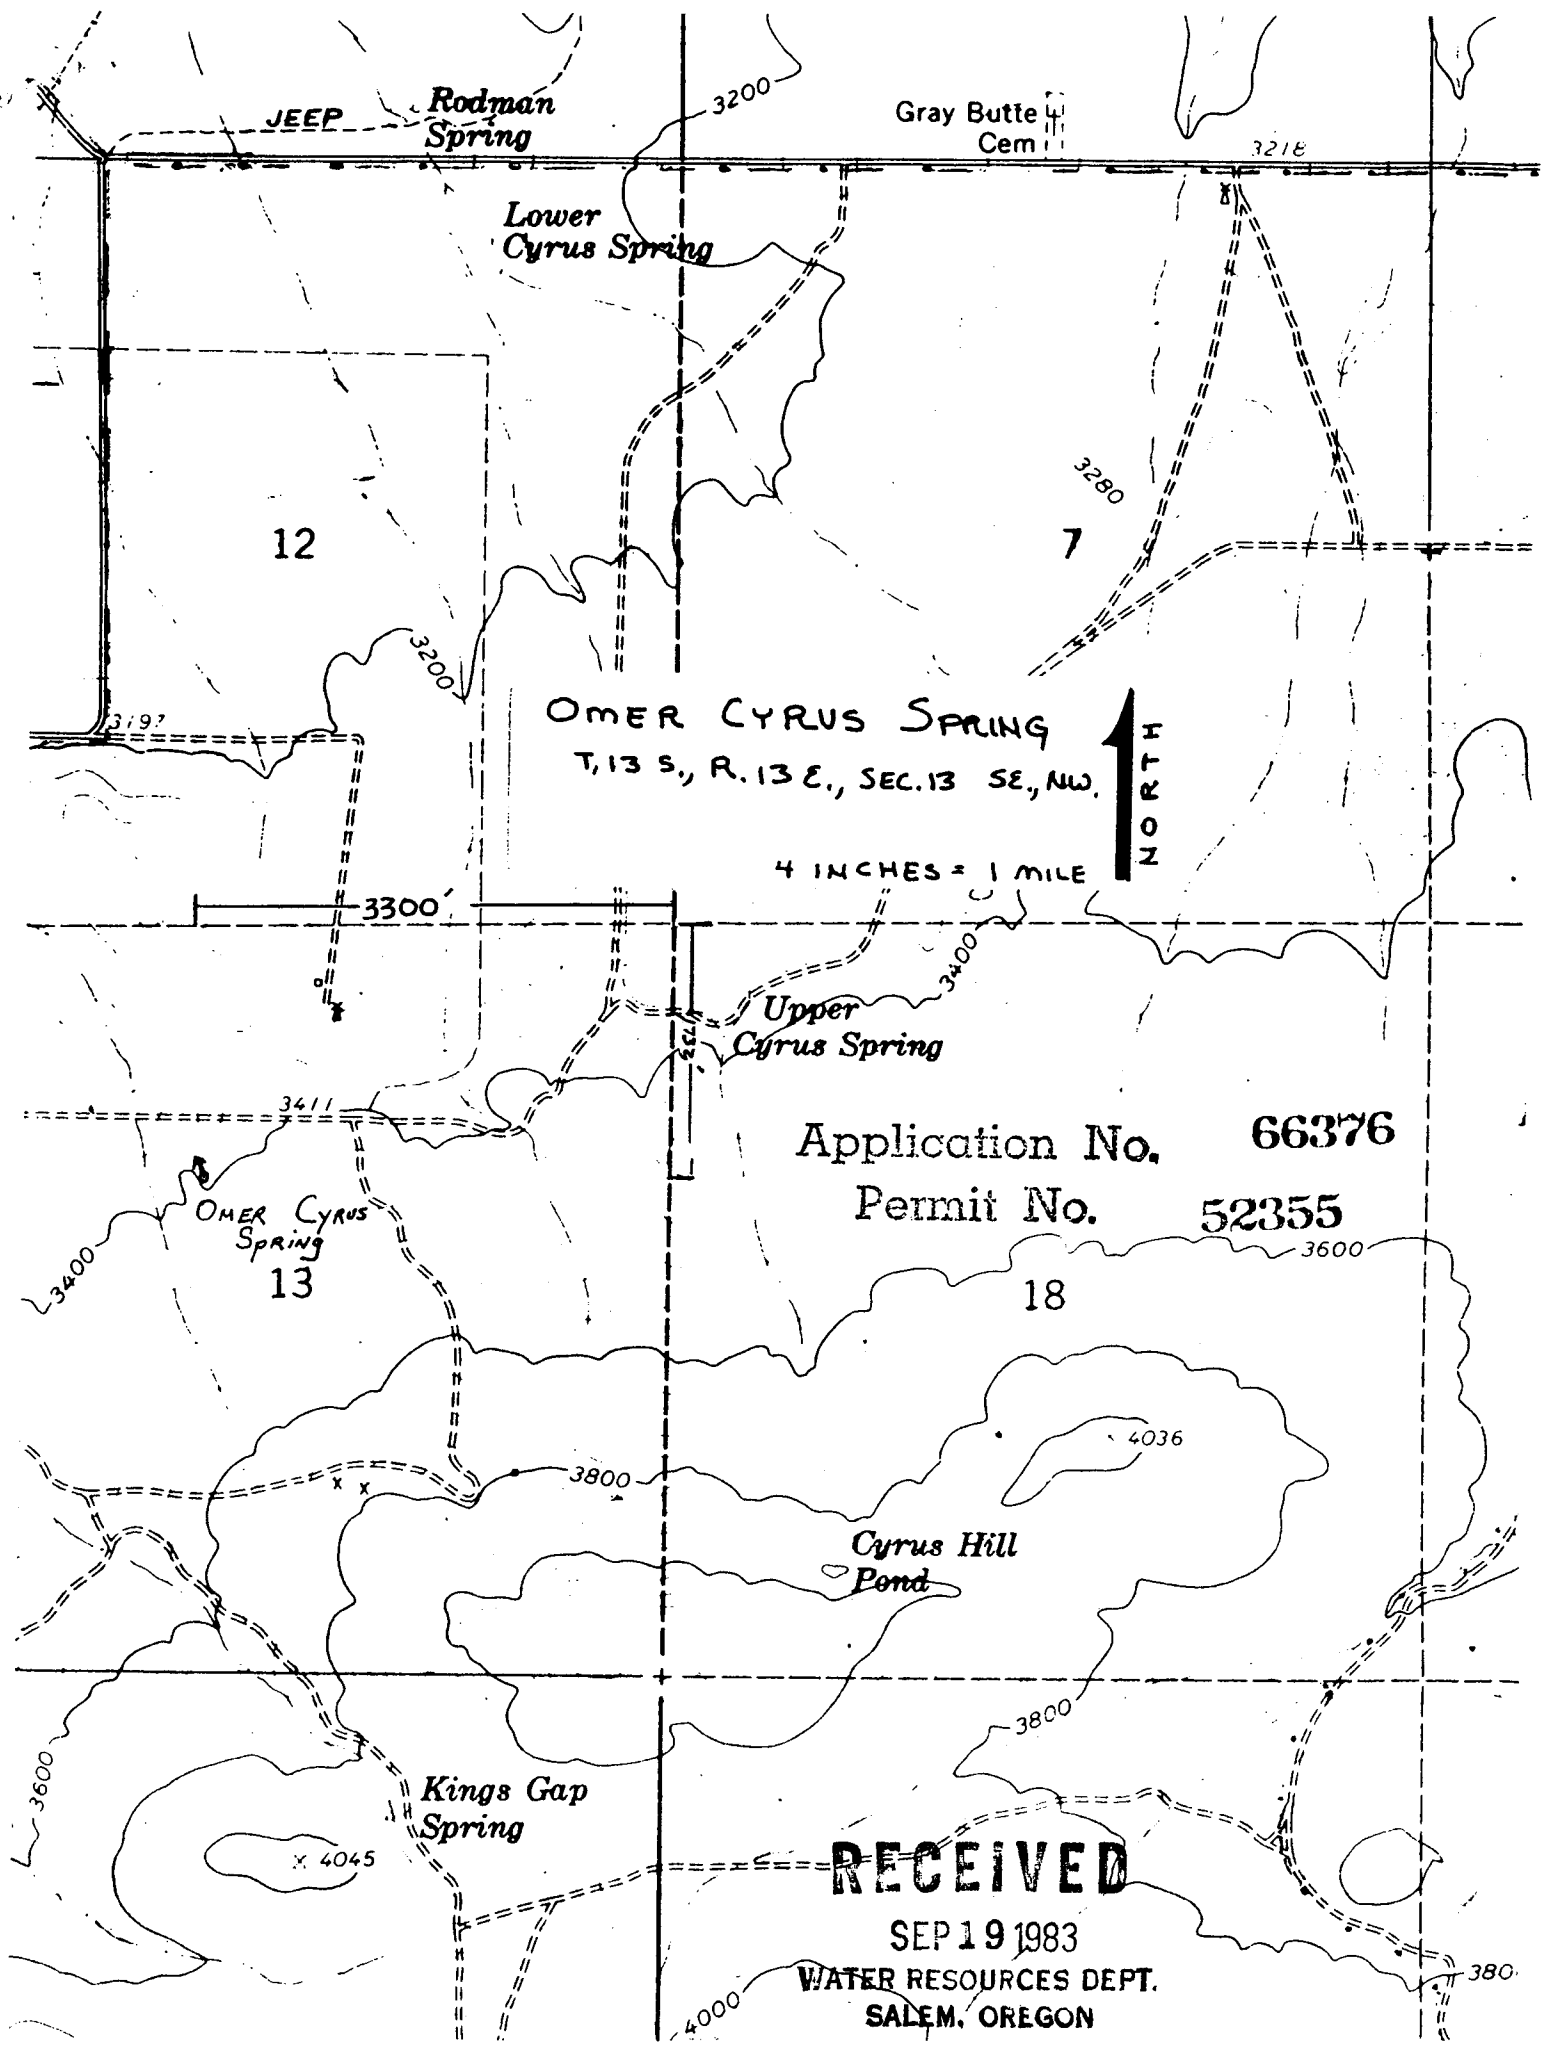

OMER CYRUS SPRING
T. 13 S., R. 13 E., SEC. 13 SE, NW.


4 INCHES = 1 MILE

Application No. 66376
Permit No. 52355

RECEIVED

SEP 19 1983
WATER RESOURCES DEPT.
SALEM, OREGON

Omer Cyrus Spring
T. 13 S., R. 13 E.,
Sec. 13, SE, NW

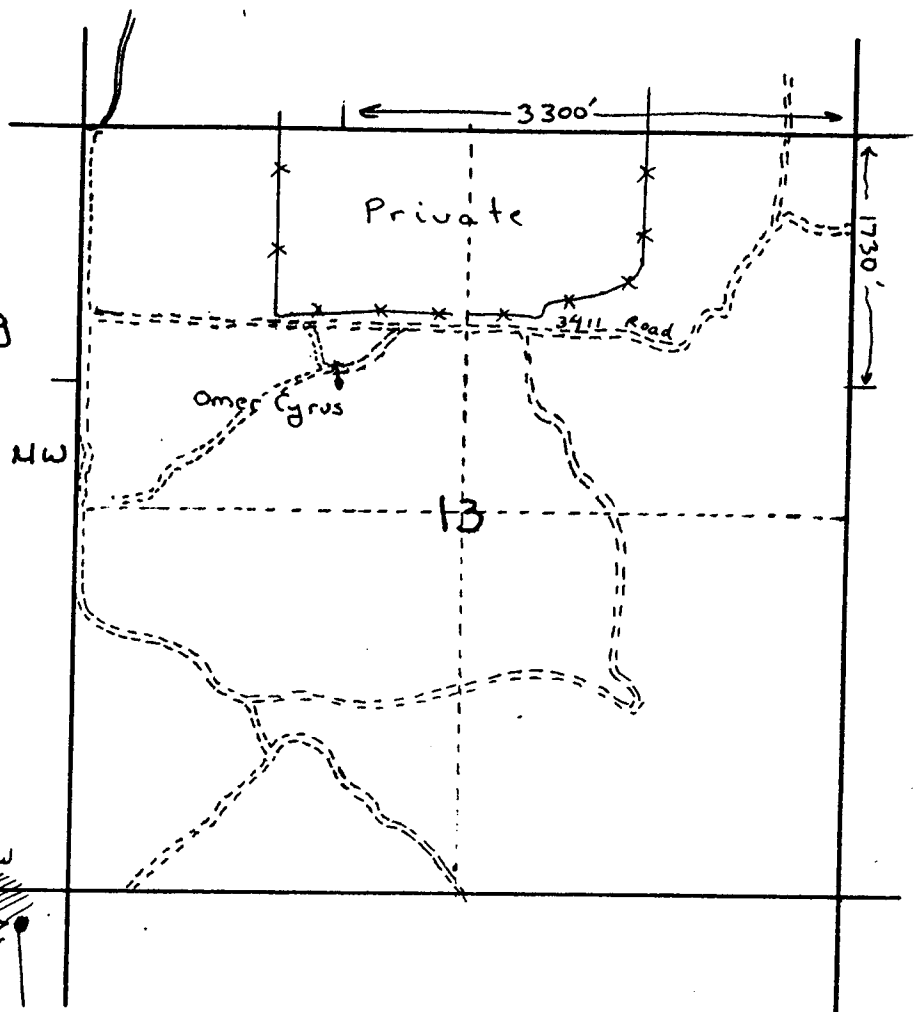

overflow
small wildlife
9433/er

overflow area
wooden tanks
oval tanks

SCALE
4" = 1 MILE



Diagram of
development at
Omer Cyrus Spring
1" = 50'

Application No. 66376
Permit No. 62355

RECEIVED

SEP 19 1983
WATER RESOURCES DEPT.
SALEM, OREGON

