

SCALE
4" = 1 mile

NORTH

Lyons Spring

T. 13 S., R. 13 E.

Section 24 SW, NW

Application No. 66382

Permit No. 52350

diagram of development
1 inch = 50 feet

Trail Crossing Pasture

3 stock tanks

125' pipeline

pole enclosure
around Spring Source
excavation

overflow crosses road & rejoins stream channel

Tanks used by cattle in
two pastures.


Cypress Pasture

RECEIVED

SEP 19 1983

WATER RESOURCES DEPT.
SALEM, OREGON

Piled Brush

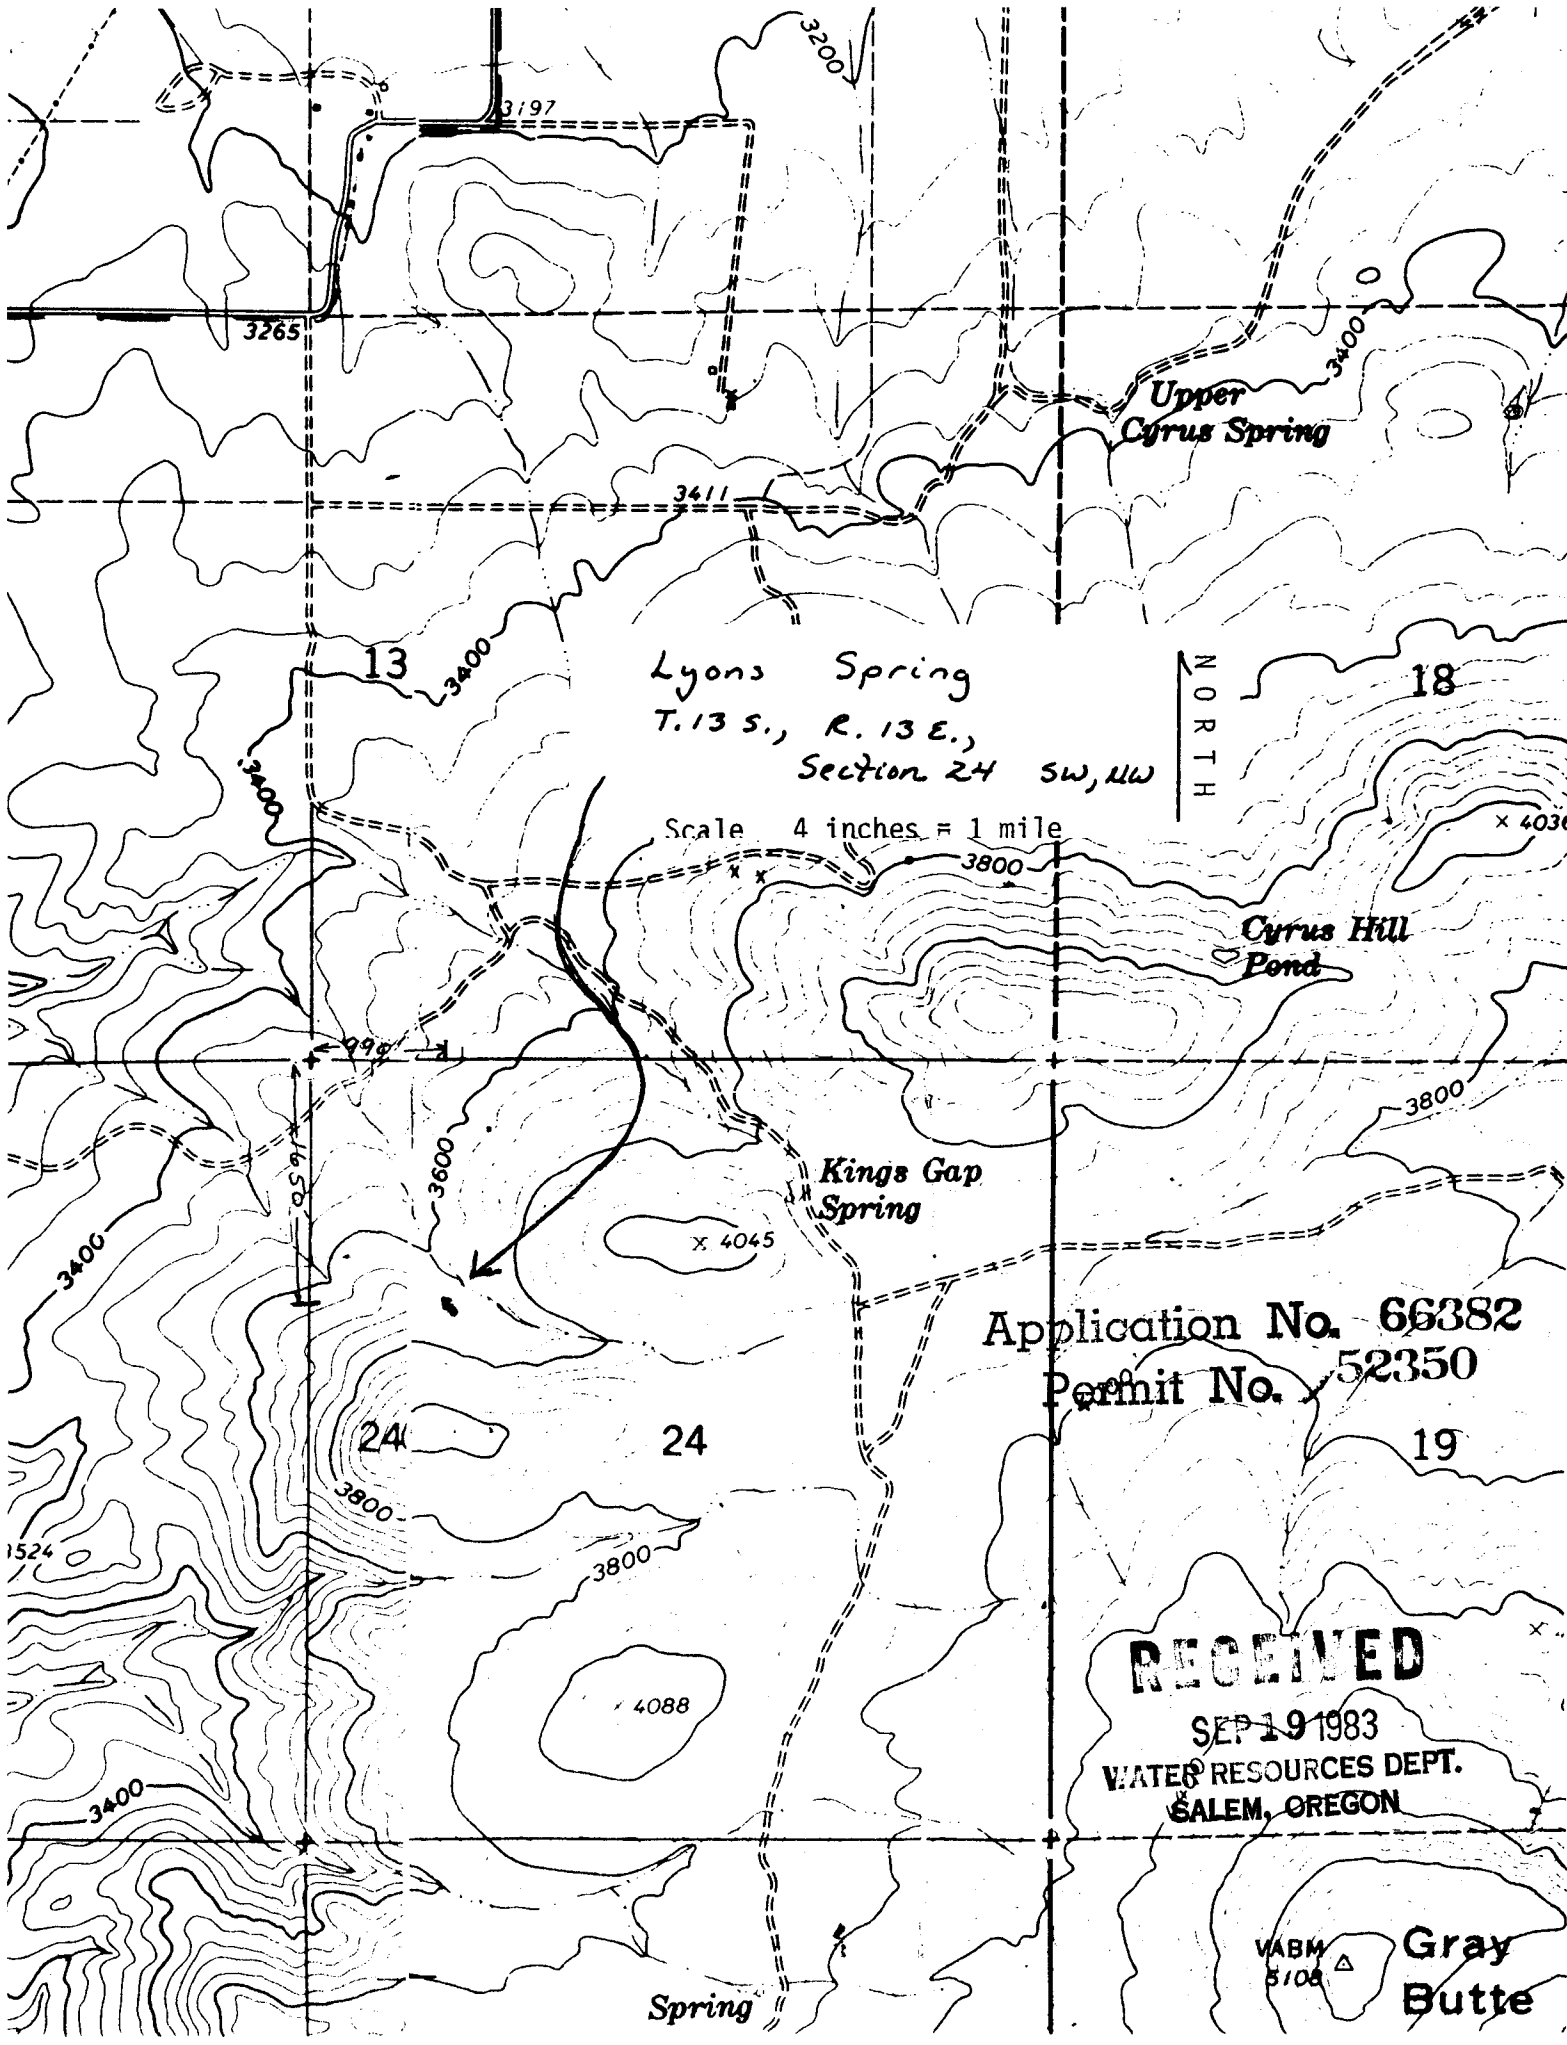

Lyons Spring
T. 13 S., R. 13 E.,
Section 24 SW, NW

Scale 4 inches = 1 mile

NORTH

Cyrus Hill
Pond

Kings Gap
Spring

Application No. 66382
Permit No. 52350

RECEIVED

SEP 19 1983
WATER RESOURCES DEPT.
SALEM, OREGON

VABM
5108

Gray
Butte

Spring