

map 1 of 2

SCALE
4" = 1 mile



Meracle Spring
T. 13 S., R. 13 E.,
Section 25 NW, SW.

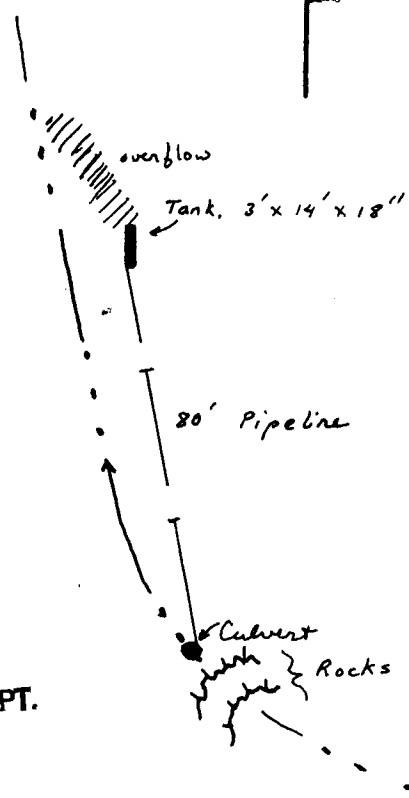
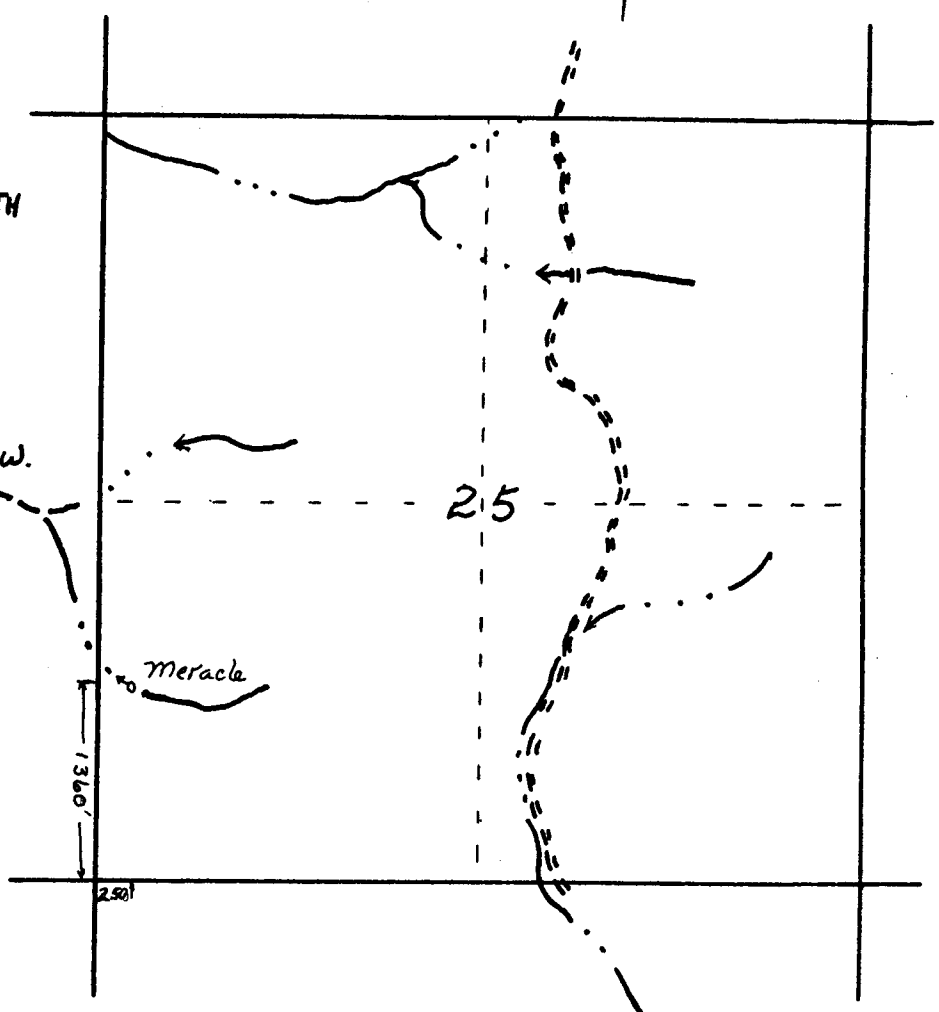


Diagram of Development
1" = 40' ↑ N

Application No. 66385
Permit No. 52347


RECEIVED

SEP 19 1983
WATER RESOURCES DEPT.
SALEM, OREGON

SCALE
4" = 1 mile

NORTH ↑

Nichols Spring
T. 13 S., R. 13 E.,
Section 26, SW, NE

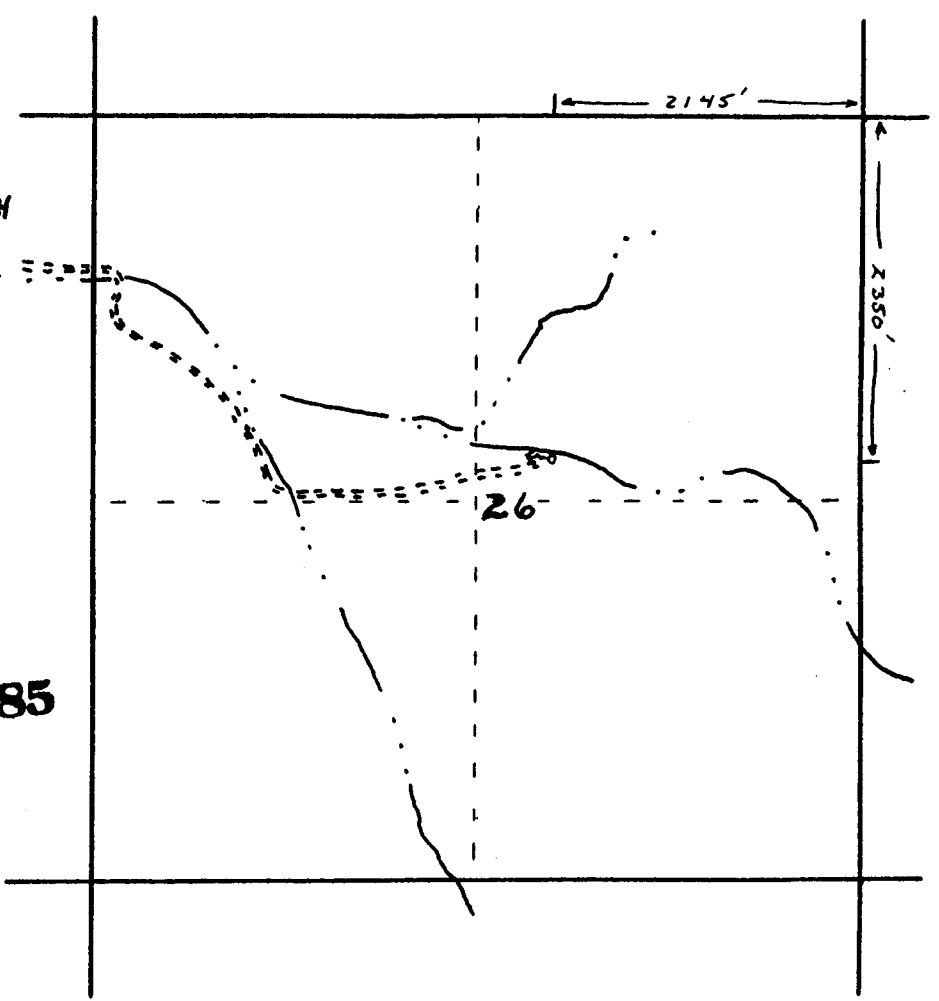


Application No. **66385**
Permit No. **52347**

diagram 1" = 50' ↑

RECEIVED

SEP 19 1983
WATER RESOURCES DEPT.
SALEM, OREGON

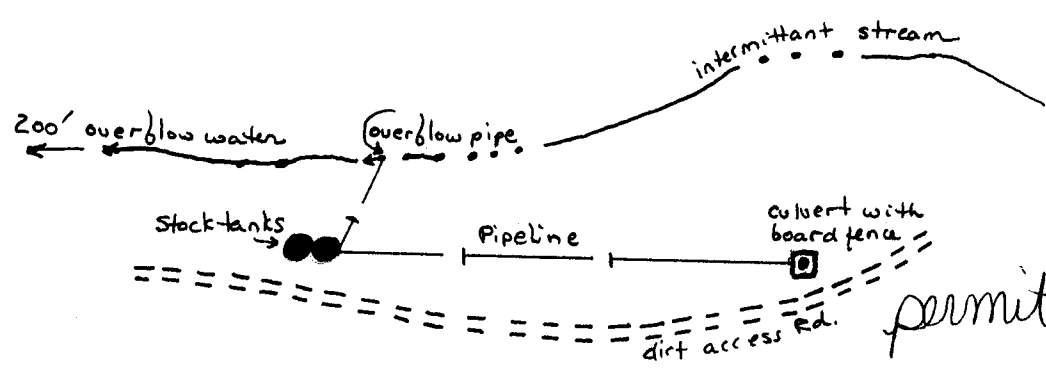

permit#

52347