


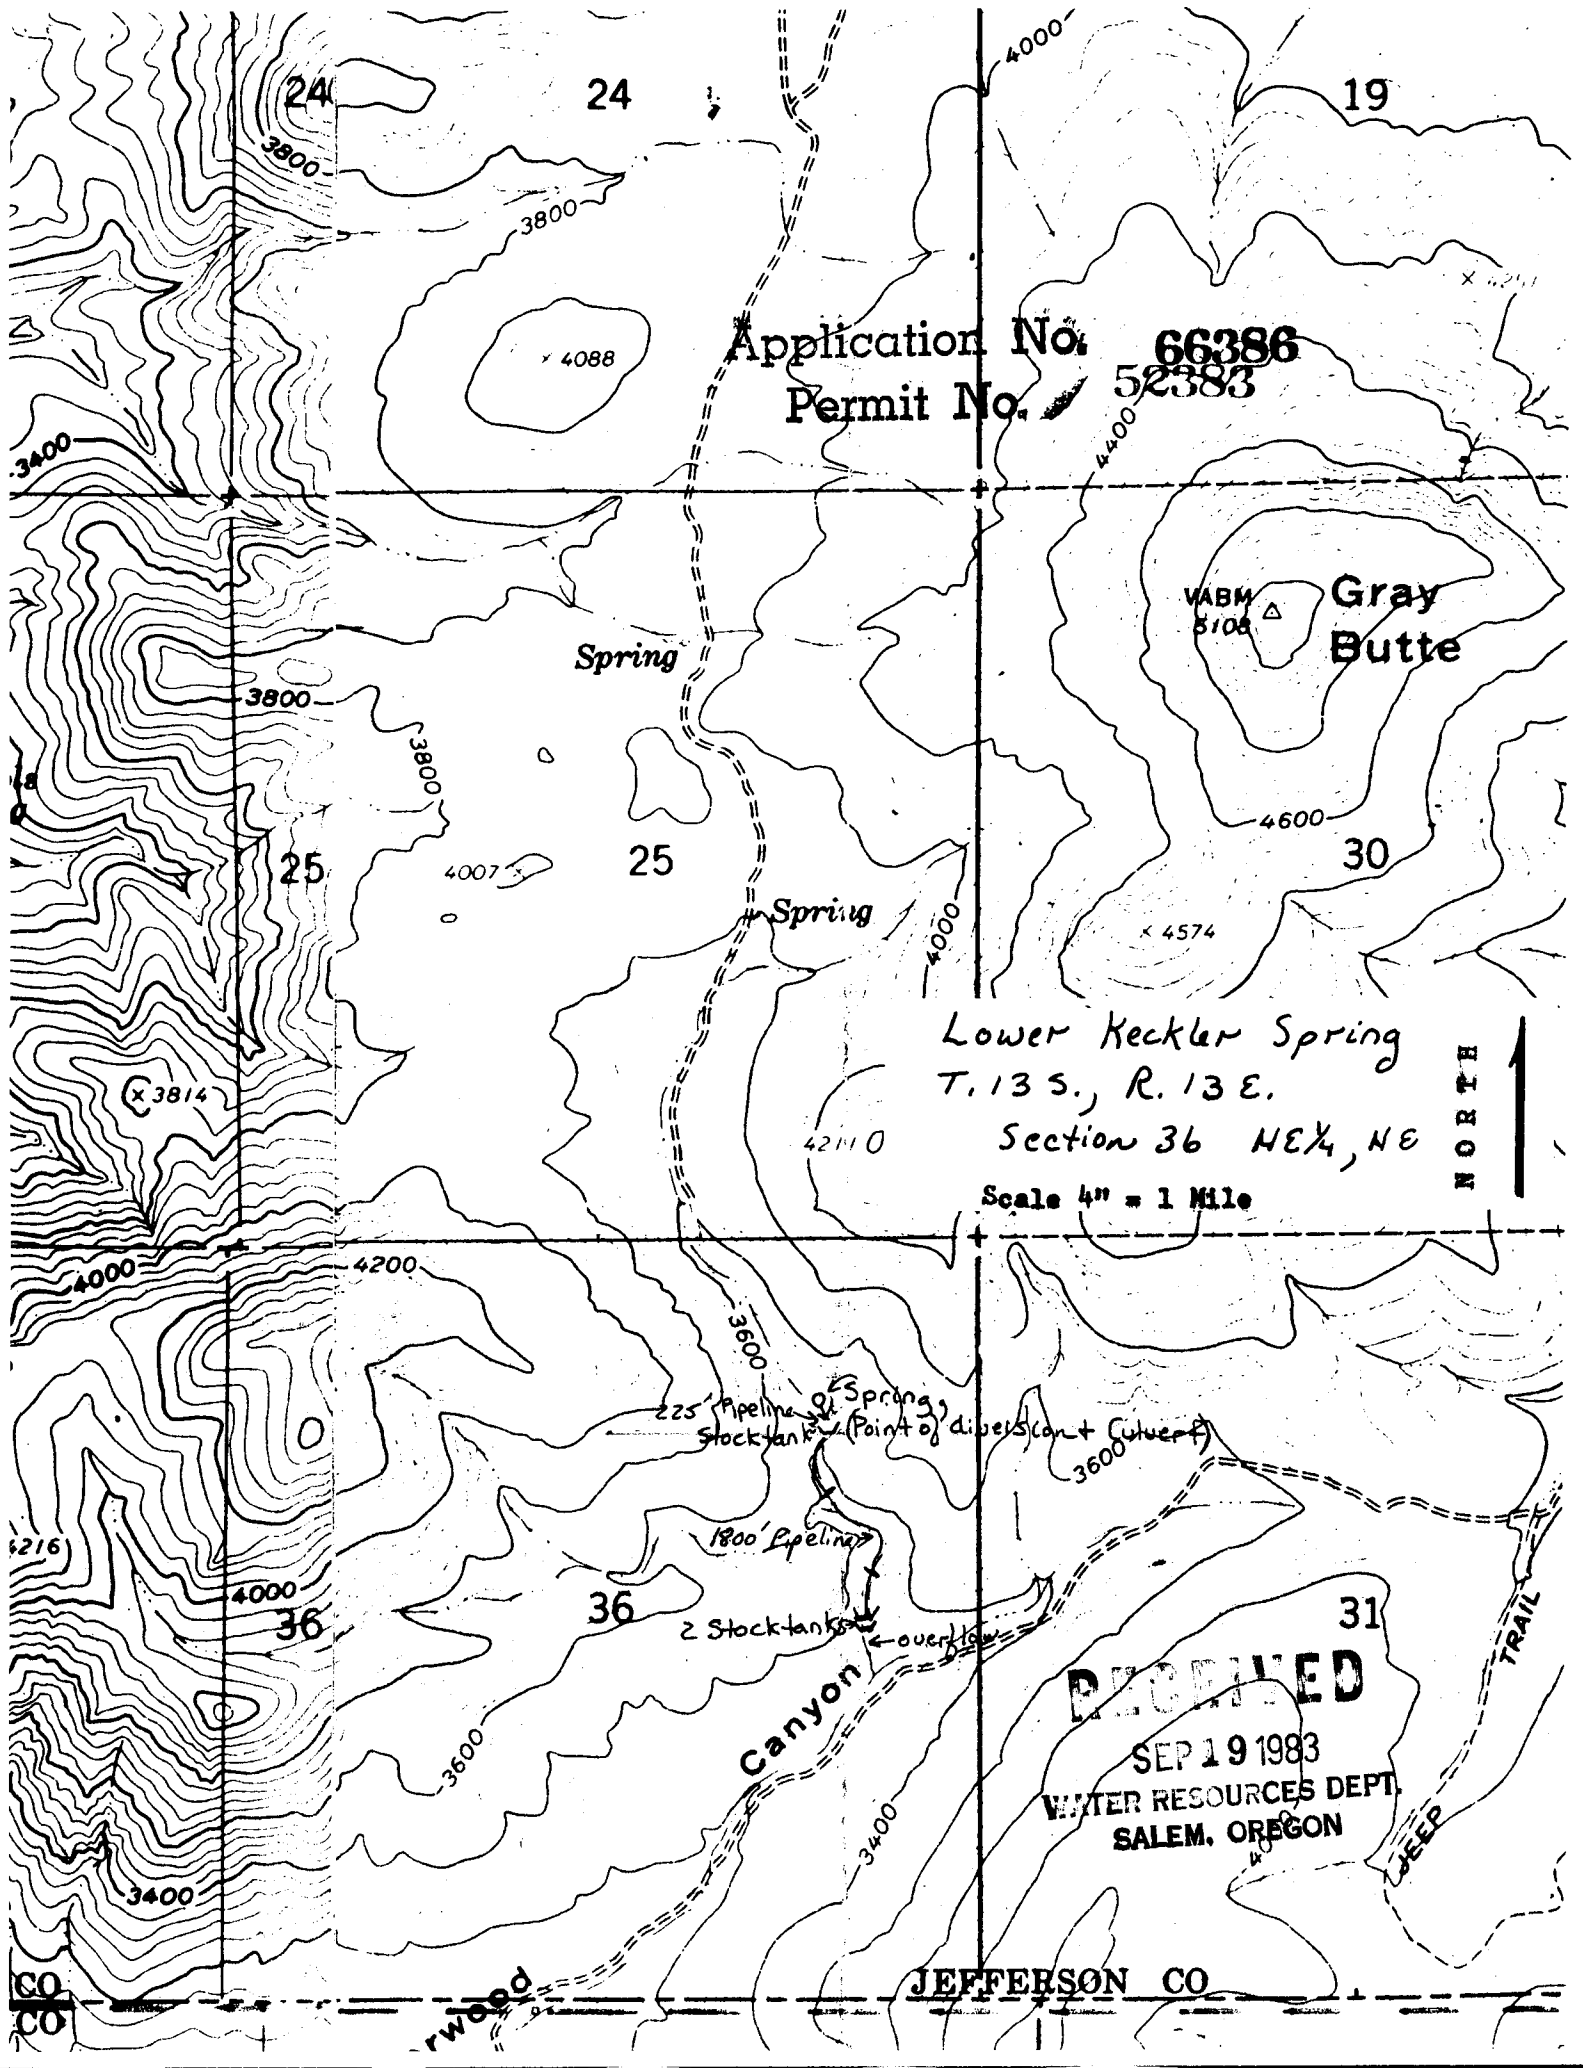

Application No. **66386**
Permit No. **52383**

Gray Butte
5108

Lower Keckler Spring
T. 13 S., R. 13 E.

Section 36 NE 1/4, NE

Scale 4" = 1 Mile

NORTH ↑

DECEIVED

SEP 19 1983
WATER RESOURCES DEPT.
SALEM, OREGON

JEFFERSON CO


SCALE
4" = 1 mile

NORTH

Lower Keakler Spring

T. 13 S., R. 13 E.

Section 36 NE, NE

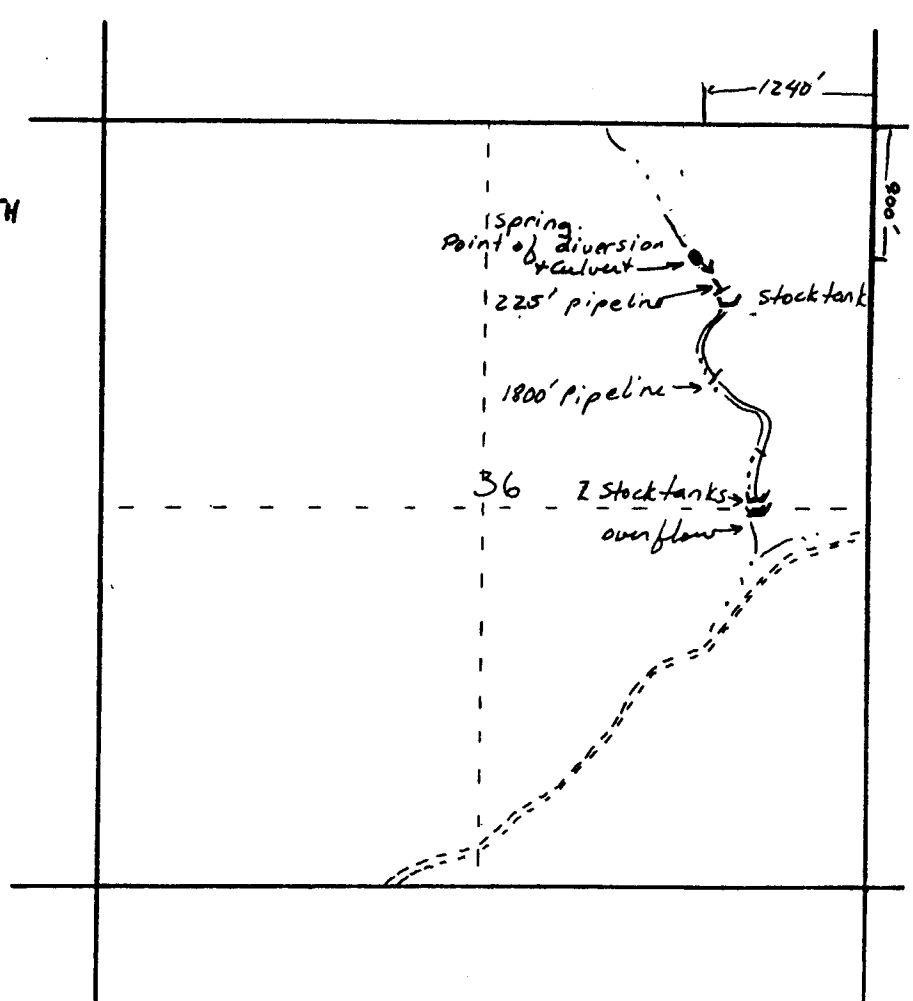

RECEIVED

SEP 19 1983

WATER RESOURCES DEPT.
SALEM, OREGON

Application No. **66386**

Permit No. 52383