

SCALE  
4" = 1 mile

NORTH

Cottman Spring

T. 13S., R. 14E.,

Section 18, NE, NE

(overflow)

Tank

Pipeline

Cottman Sp.


18

Application No. 66387

Permit No. 52384

Diagram of Development

1" = 100'

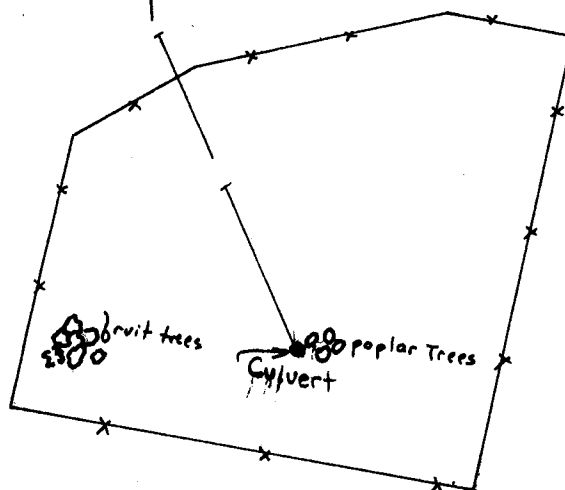

**RECEIVED**

SEP 19 1983  
WATER RESOURCES DEPT.  
SALEM, OREGON