

DOE SPRING
T.13S., R.14E., Sec. 29 NE, NW


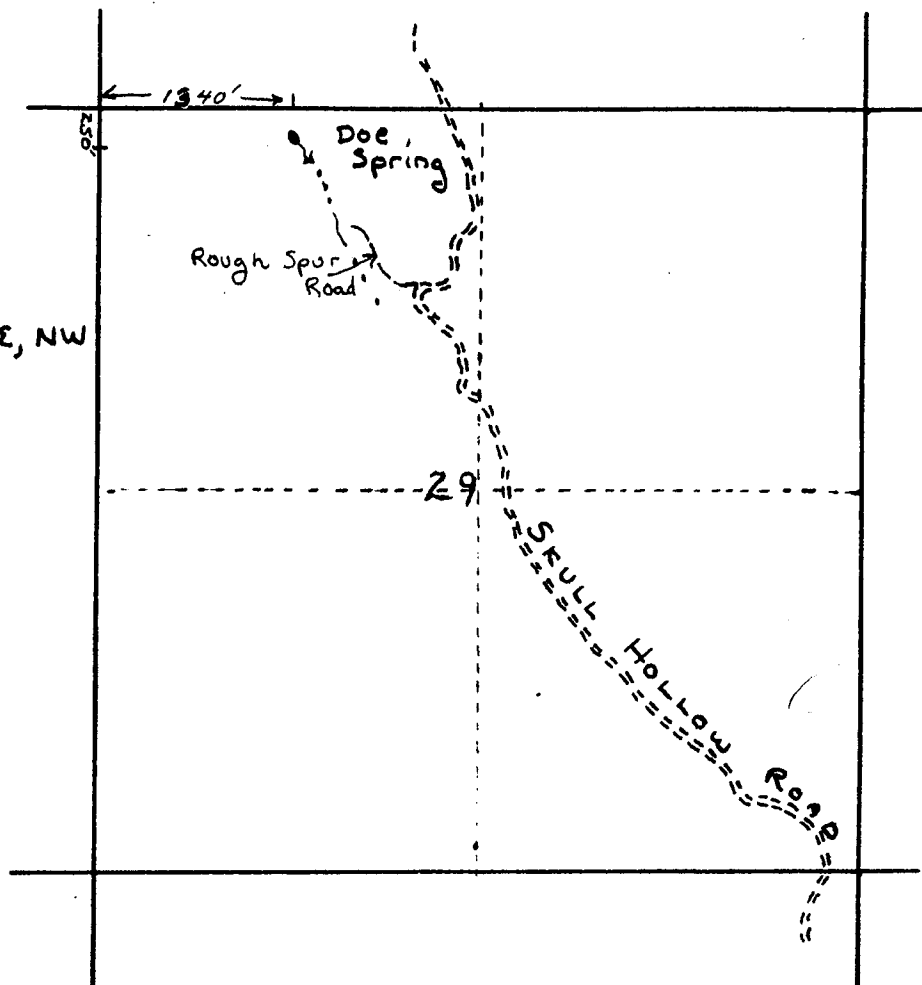


Diagram of Spring
Scale 1" = 40'

Pine Ridge Pasture
SCALE 4" = 1 MILE

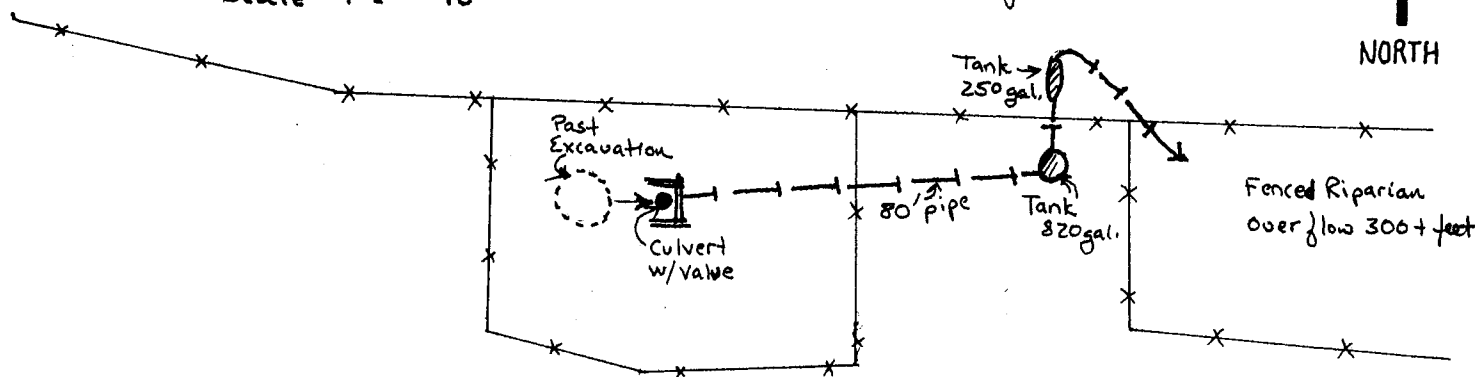

Application No. 66388

Permit No. 52400

Sherwood Canyon Pasture

RECEIVED

SEP 19 1983

WATER RESOURCES DEPT.
SALEM, OREGON

Application No.

66388

Permit No. 52400

19

20

DOE SPRING
T. 13S., R. 14E., Sec. 29 NE, NW

Scale 4 inches = 1 mile

NORTH

Red Top
Spring

Spring

VABM
5108

Gray
Butte

4600

30

4574

4000

3800

29
Spring

3400

Skull Hollow

3400

3200

3800

31

TRAIL

32

RECEIVED

SEP 19 1983

WATER RESOURCES DEPT.
SALEM, OREGON