

Eden Spring
T. 13 S., R. 14 E.,
Sec. 30 NE, NE.


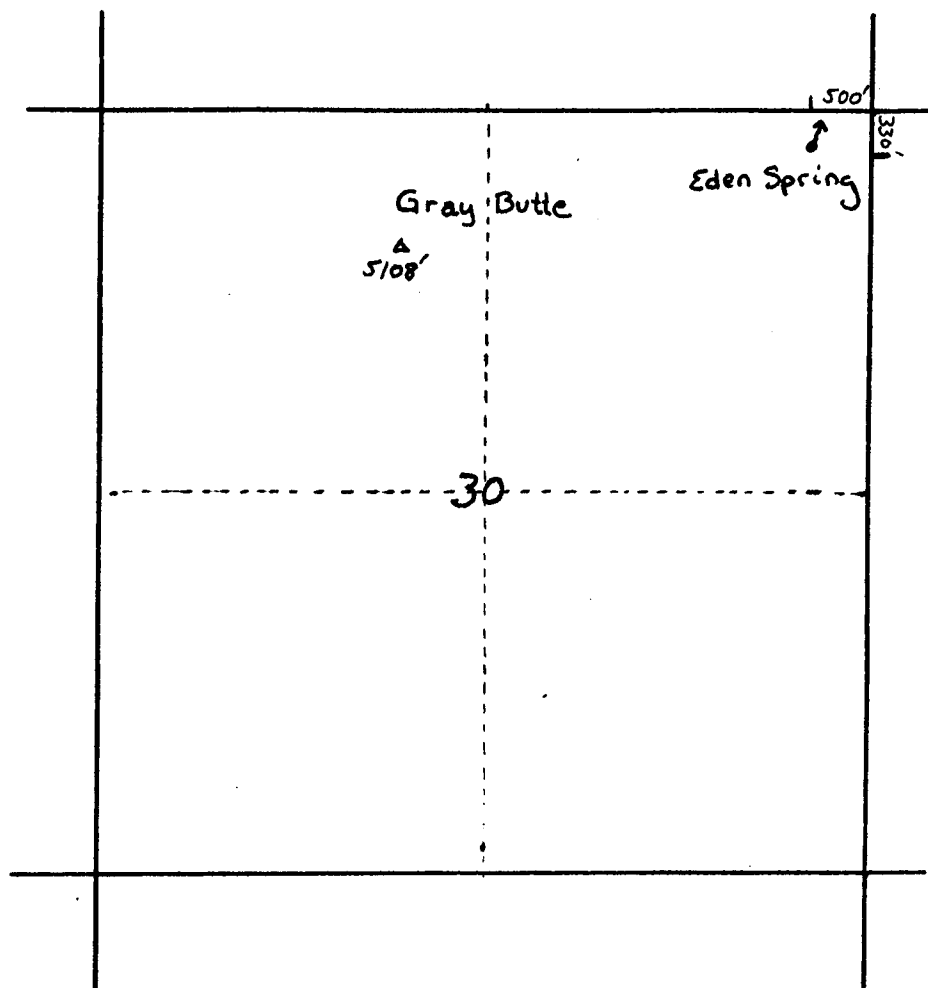


Diagram of Eden Spring
1 inch = 50'

Application No. 66390
Permit No. 52381

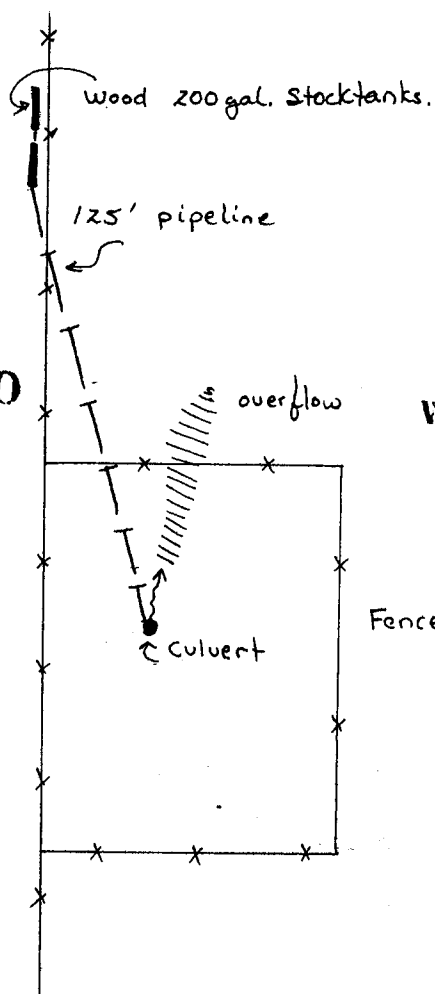


SCALE
4" = 1 MILE

1
NORTH

RECEIVED

SEP 19 1983
WATER RESOURCES DEPT.
SALEM, OREGON

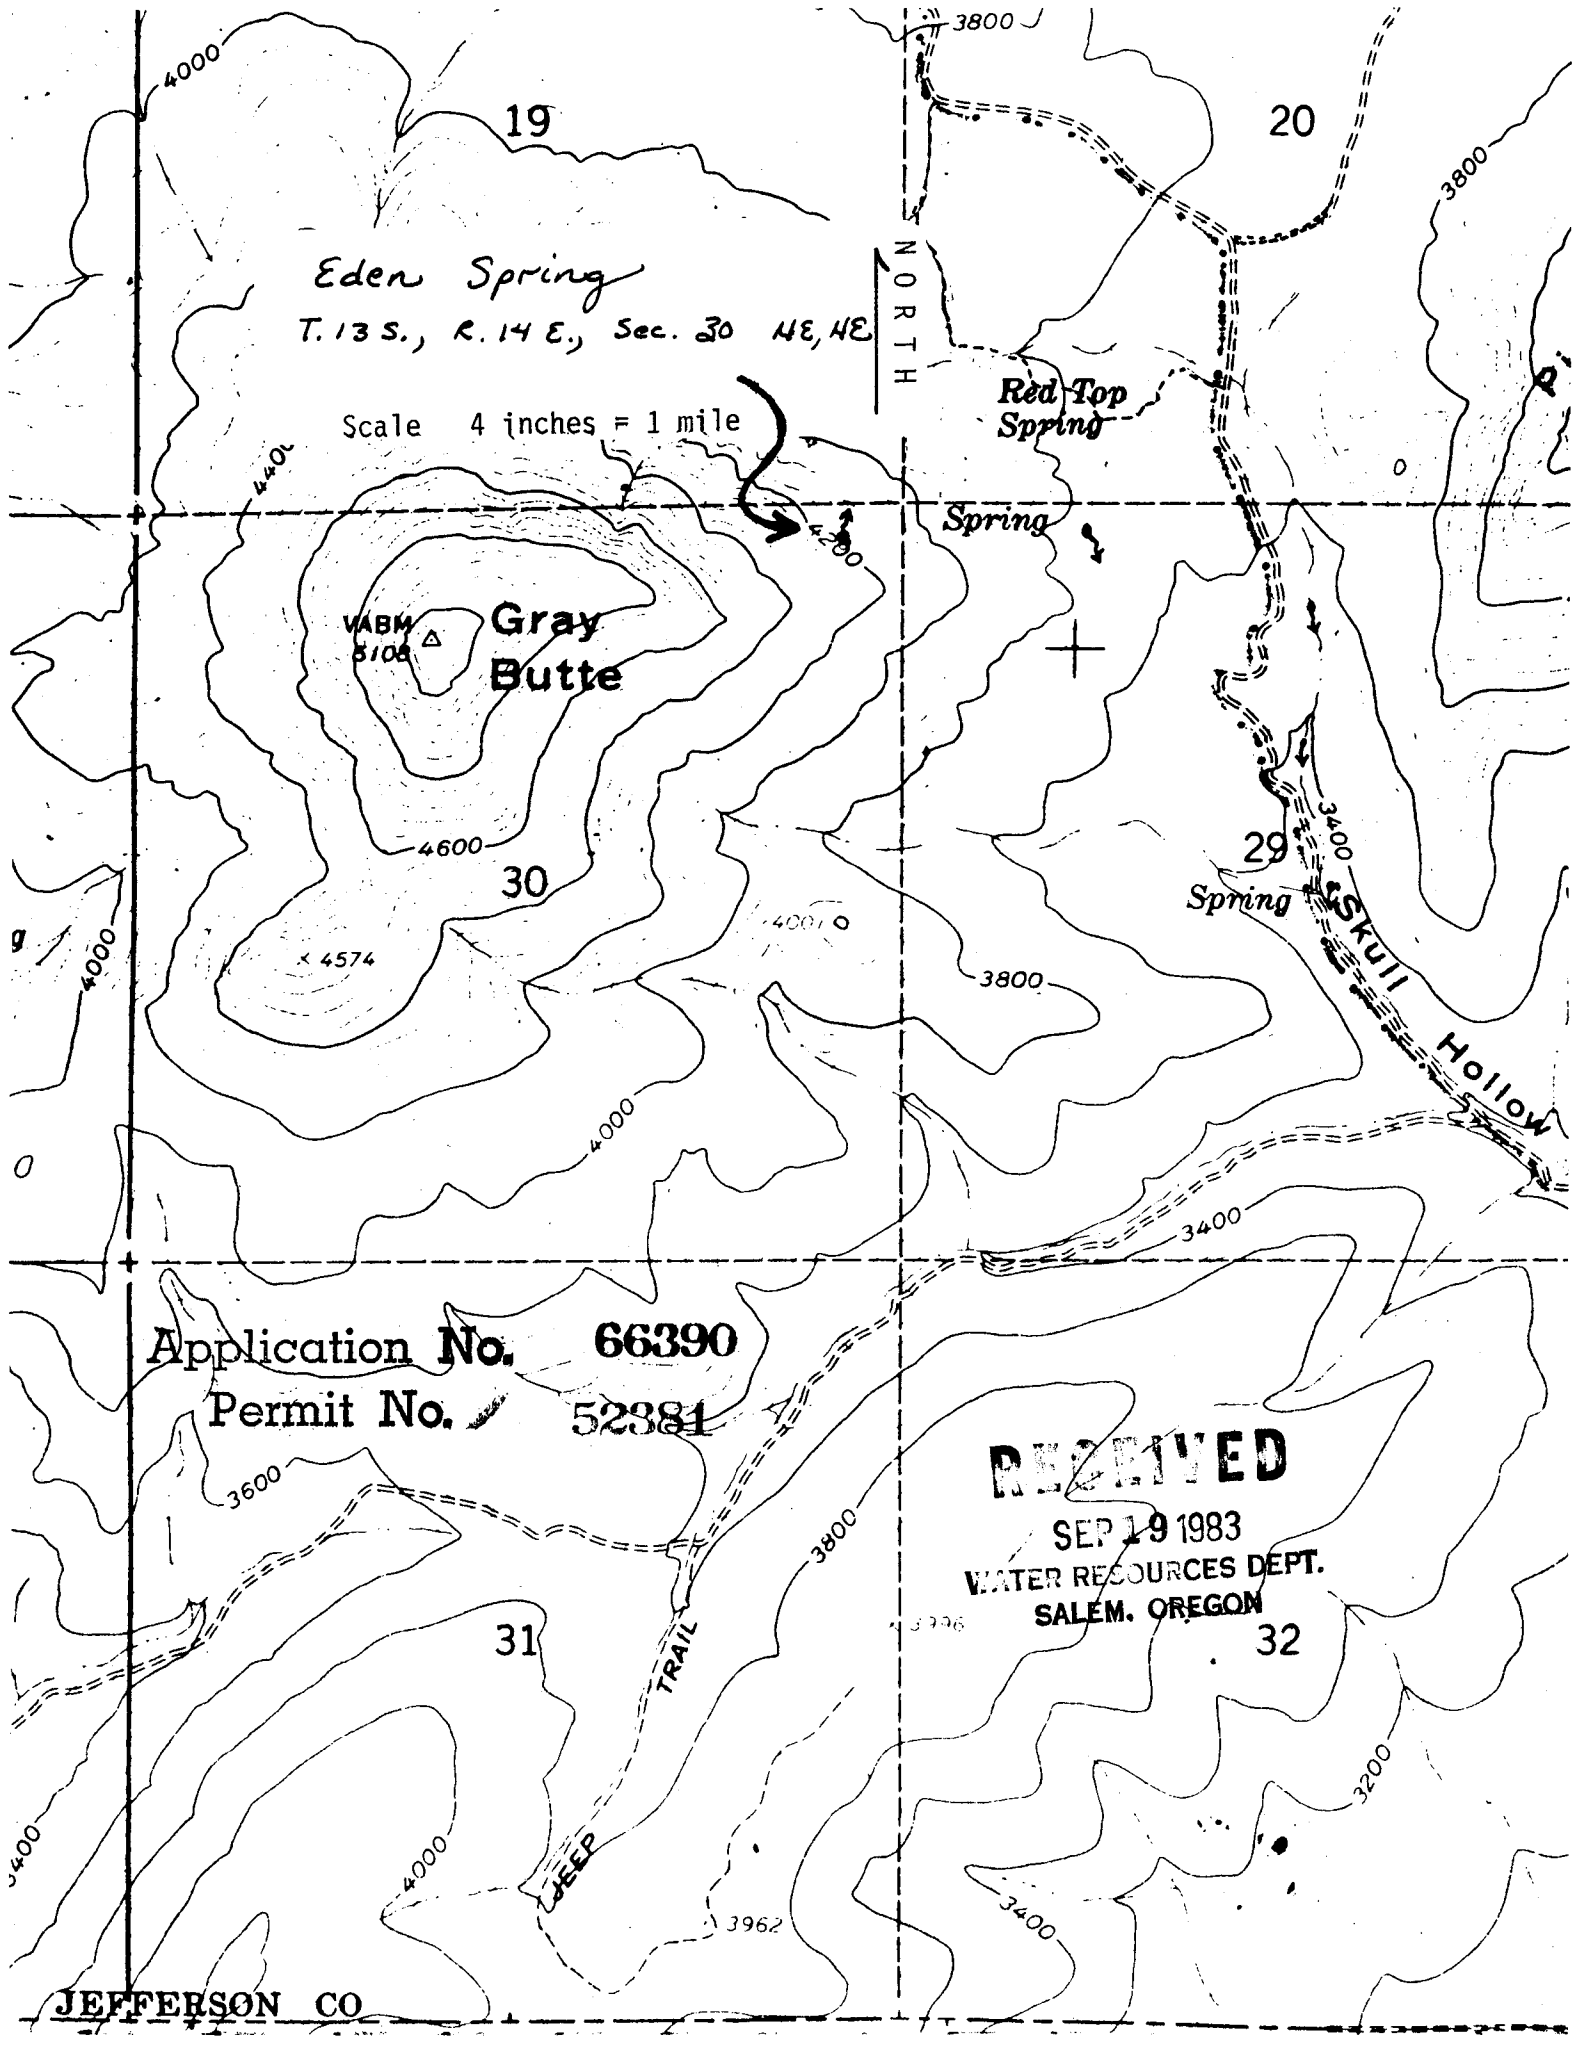

Eden Spring

T. 13 S., R. 14 E., Sec. 30 NE, NE

Scale 4 inches = 1 mile

NORTH

Red Top Spring

Spring

VABM
5106

Gray Butte

29
Spring

Skull Hollow

Application No. 66390

Permit No. 52381

RECEIVED

SEP 19 1983
WATER RESOURCES DEPT.
SALEM, OREGON

JEFFERSON CO