
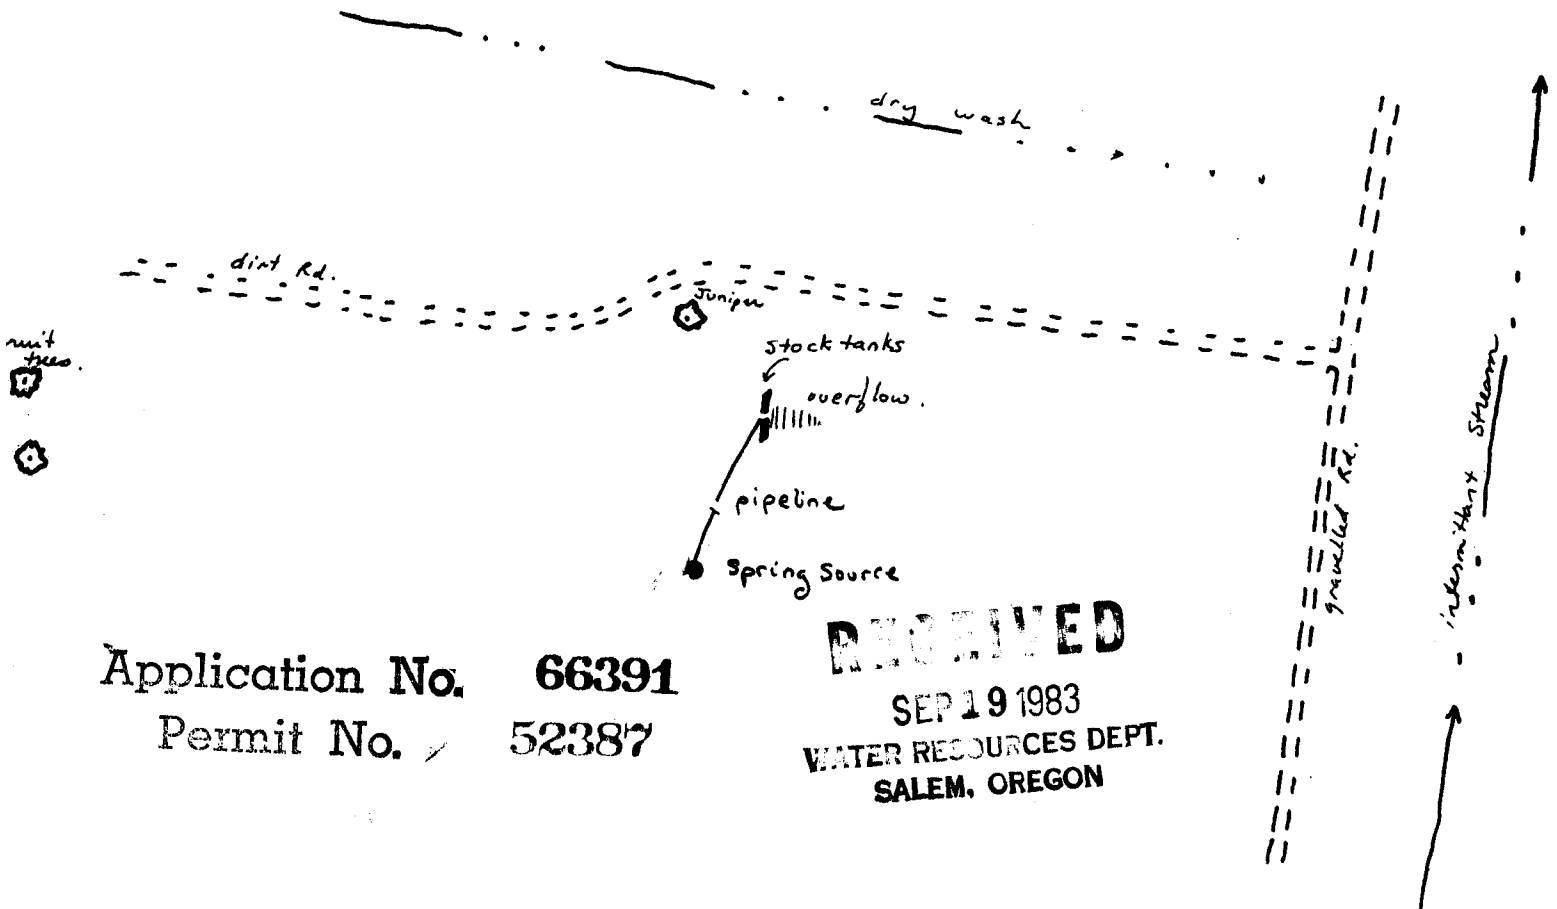


SCALE
4" = 1 mile

NORTH

Lithgow Spring.
T. 13 S., R. 14 E.,
Section 17 NE, NW

diagram
1" = 100'

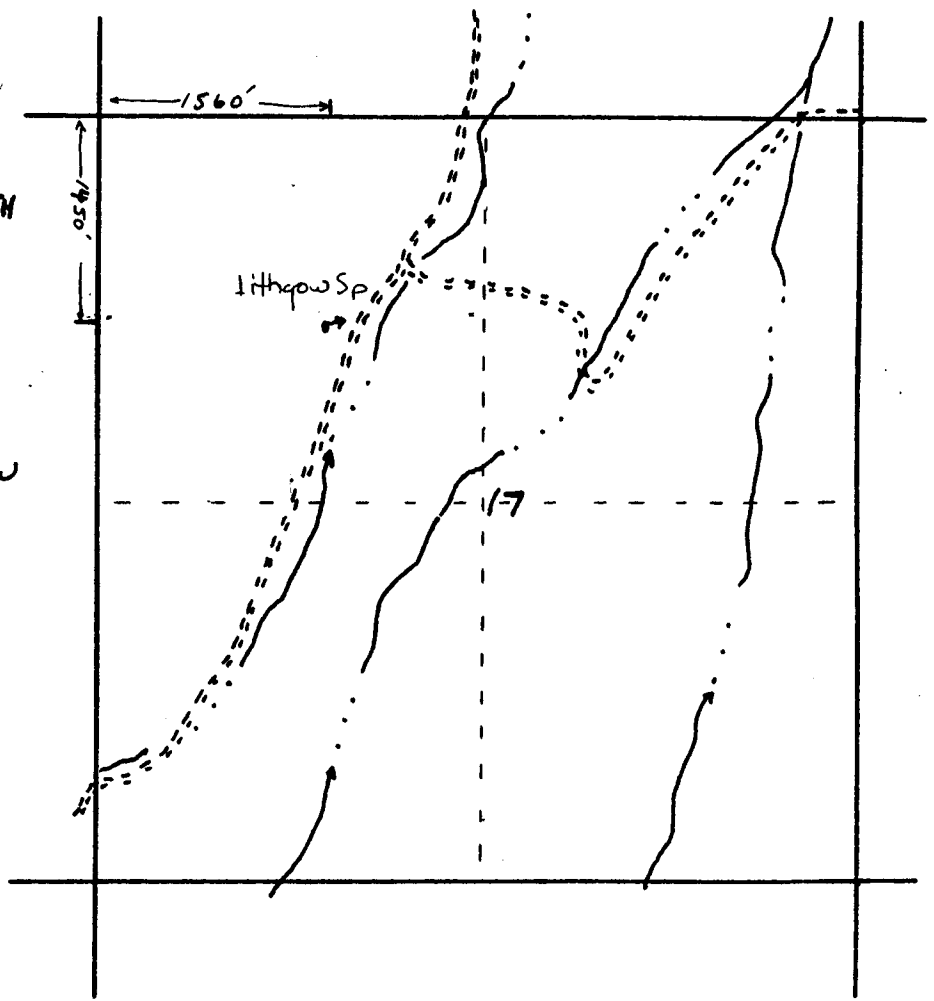

Application No. 66391
Permit No. 52387

RECEIVED
SEP 19 1983
WATER RESOURCES DEPT.
SALEM, OREGON