

SCALE
4" = 1 mile

NORTH

Paxton Spring

T. 13 S., R. 14 E

Section 13. NE, NE


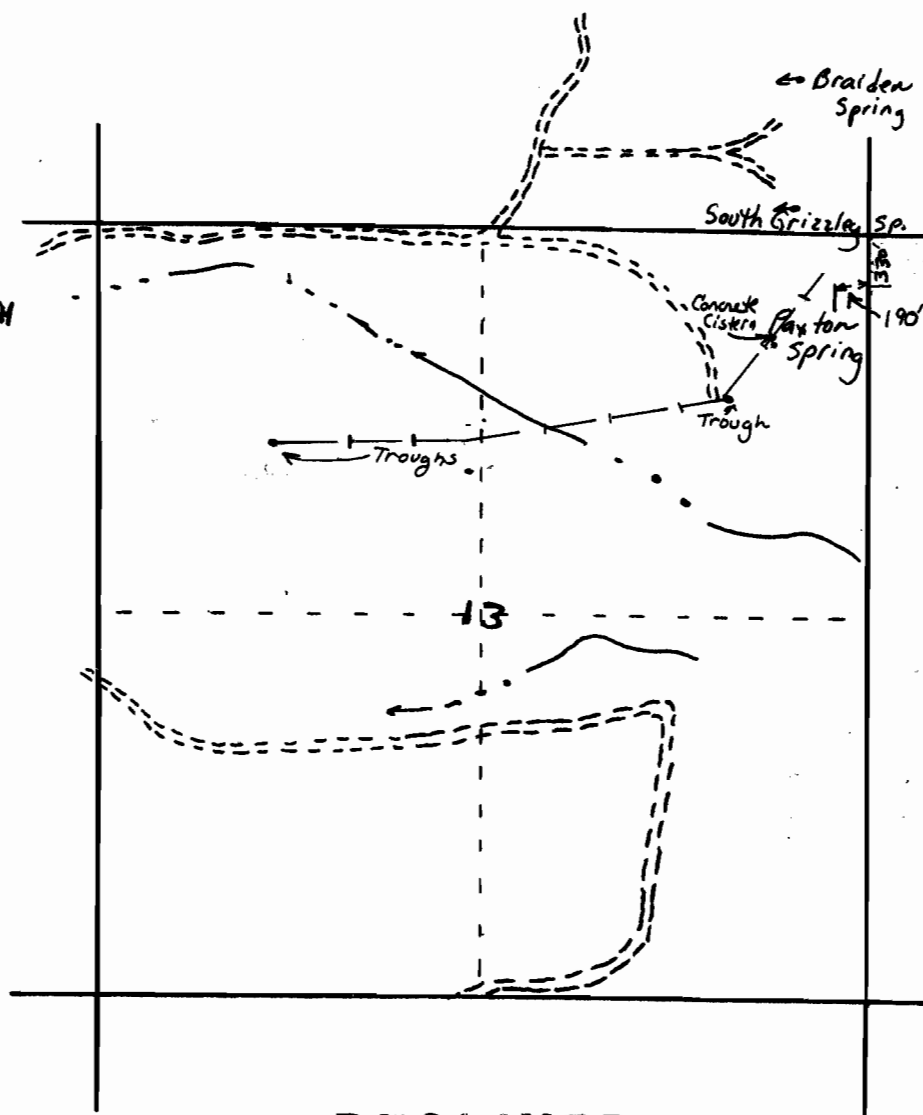


Diagram of Development

1" = 200'

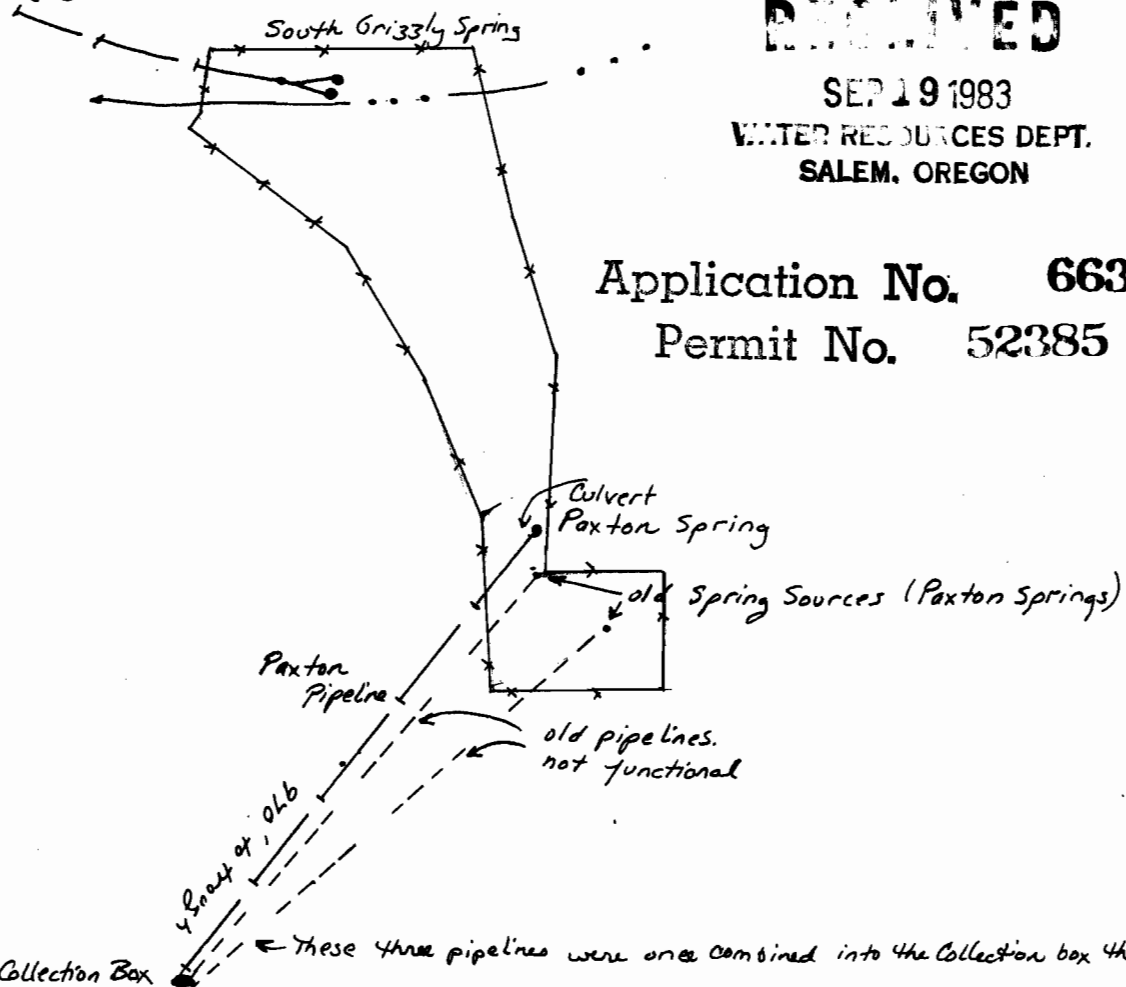

RECEIVED

SEP 19 1983

WATER RESOURCES DEPT.
SALEM, OREGON

Application No. 66392

Permit No. 52385

Collection Box

These three pipelines were once combined into the Collection box then piped to Tanks