
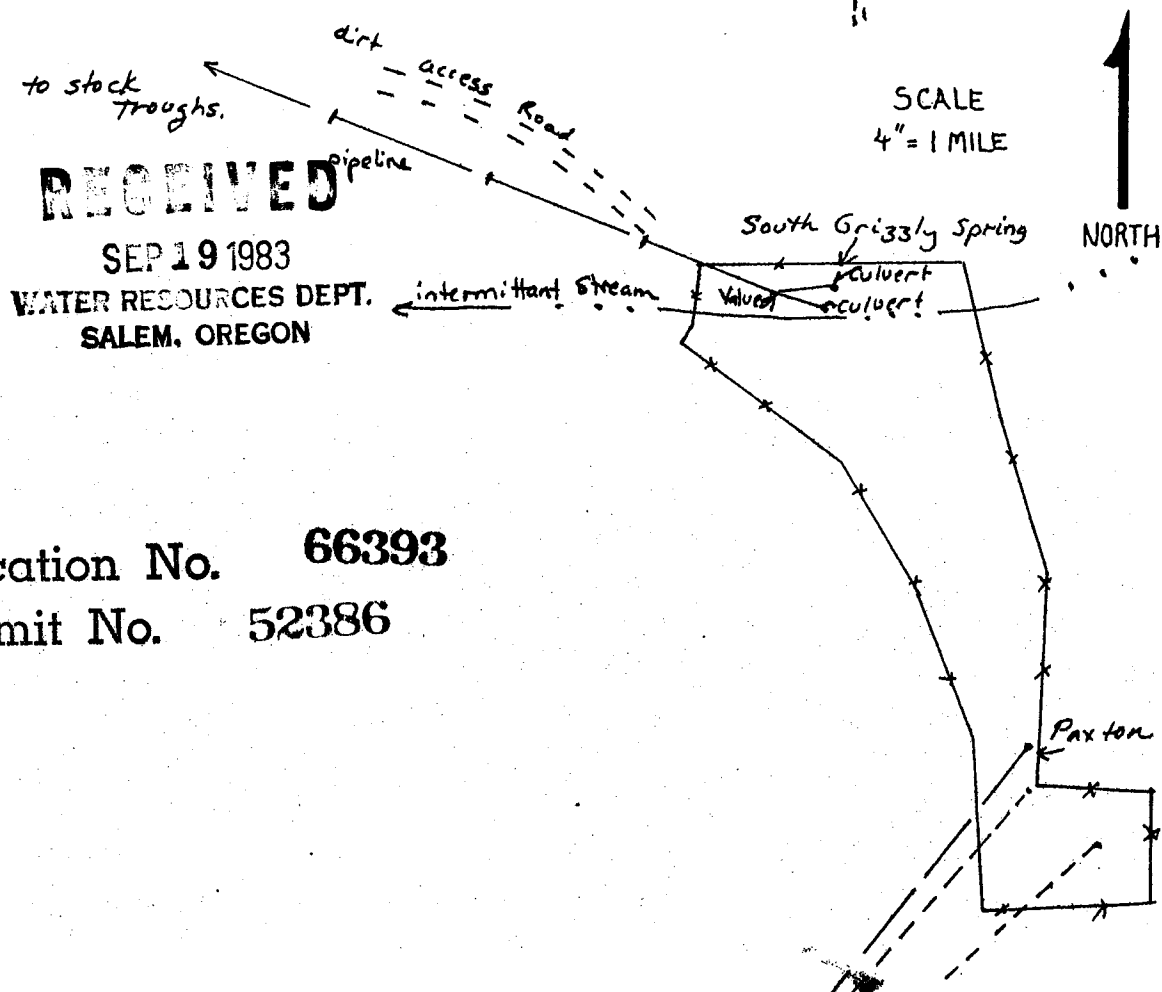


South Grizzly Spring
T. 13S., R. 14E.
Section 12. SE, SE.

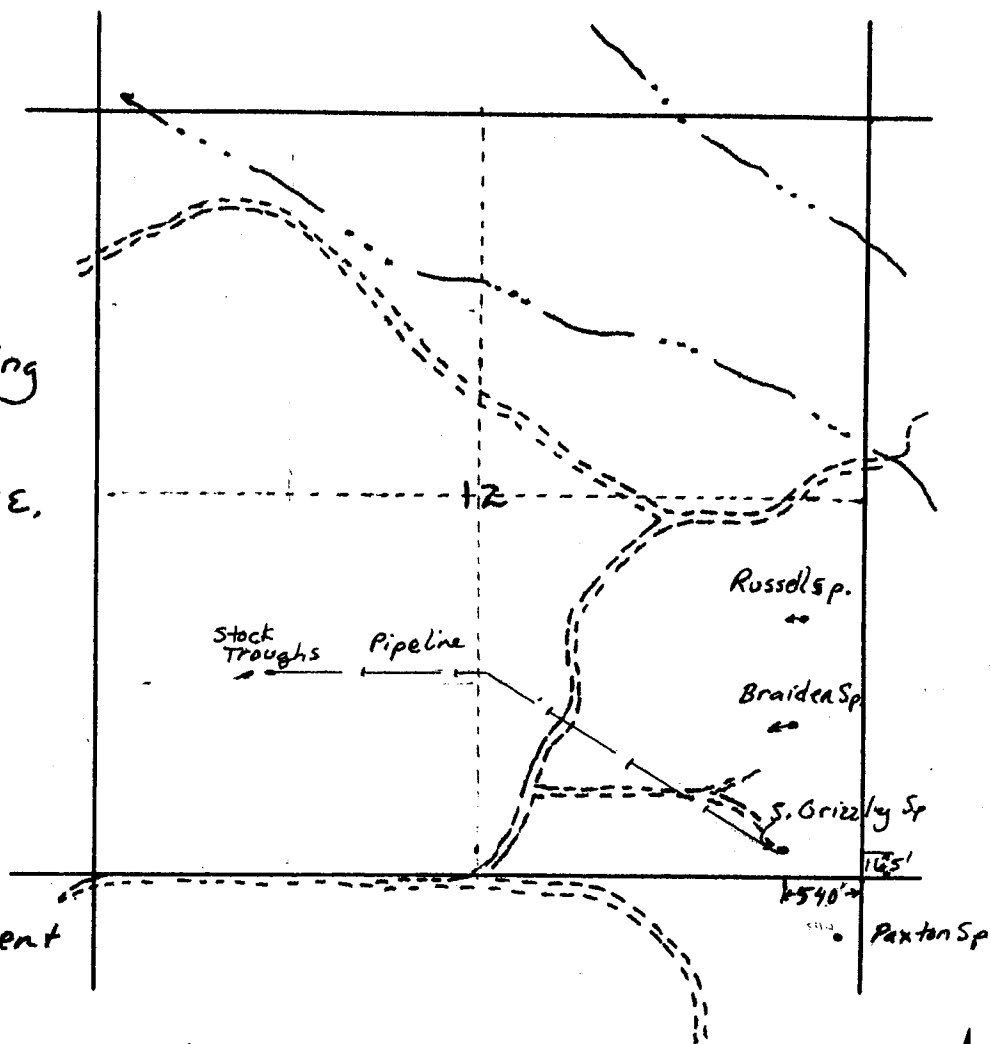

RECEIVED
SEP 19 1983
WATER RESOURCES DEPT.
SALEM, OREGON

Application No. 66393
Permit No. 52386