

Braiden Spring
T. 13 S., R. 14 E.,
Section 12, SE, SE

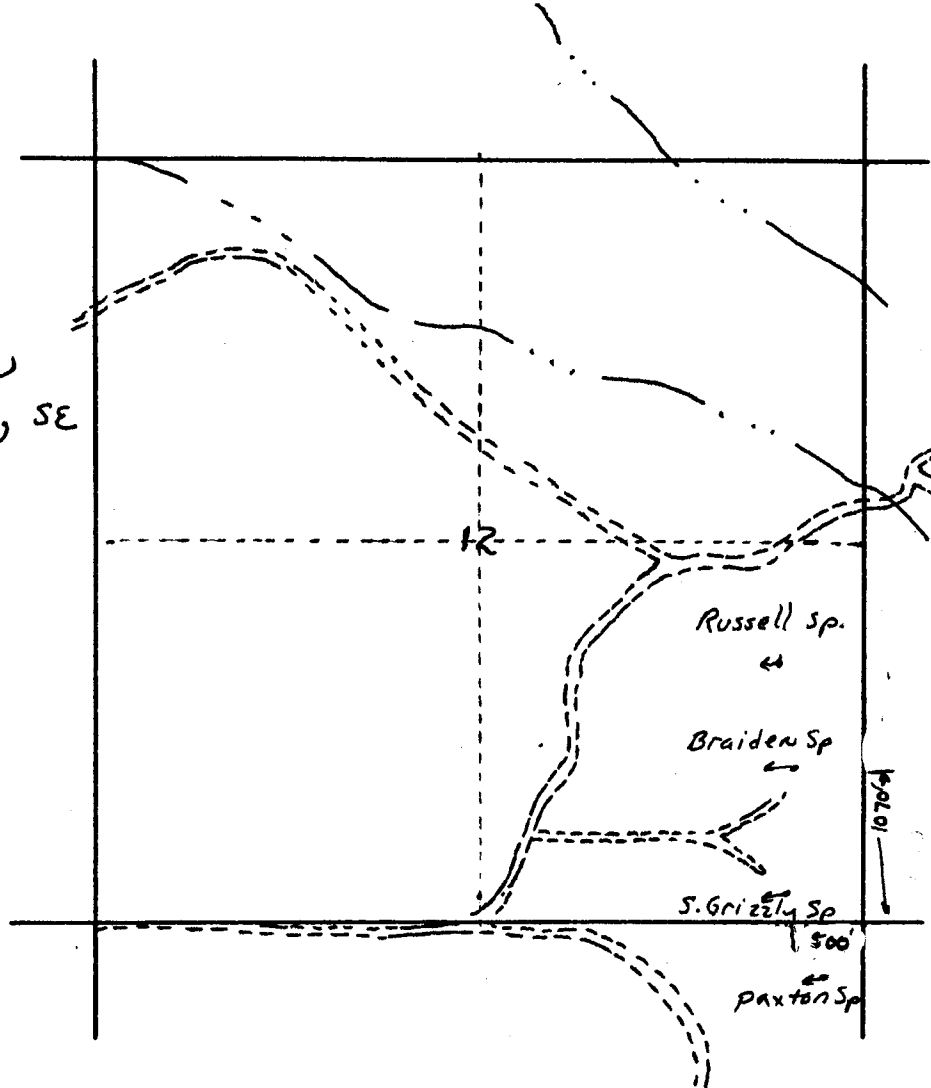


Diagram of Development.
1" = 100'

North


RECEIVED

SEP 19 1983

WATER RESOURCES DEPT.
SALEM, OREGON

SCALE
4" = 1 MILE

1
NORTH

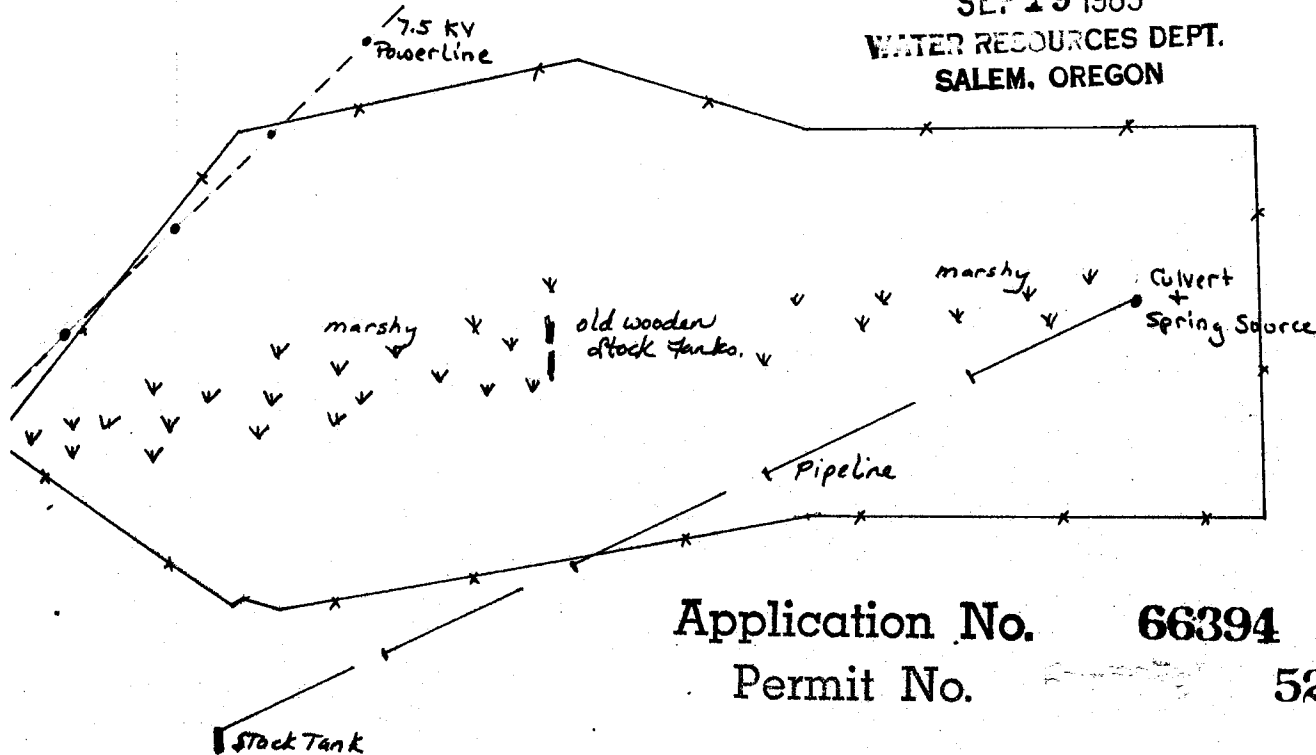

Application No.

66394

Permit No.

52380