


SCALE
4" = 1 mile
NORTH

Russell Spring
T. 13 S., R. 14 E.,
Section 12. NE, SE


Diagram of Development

1" = 50'

N

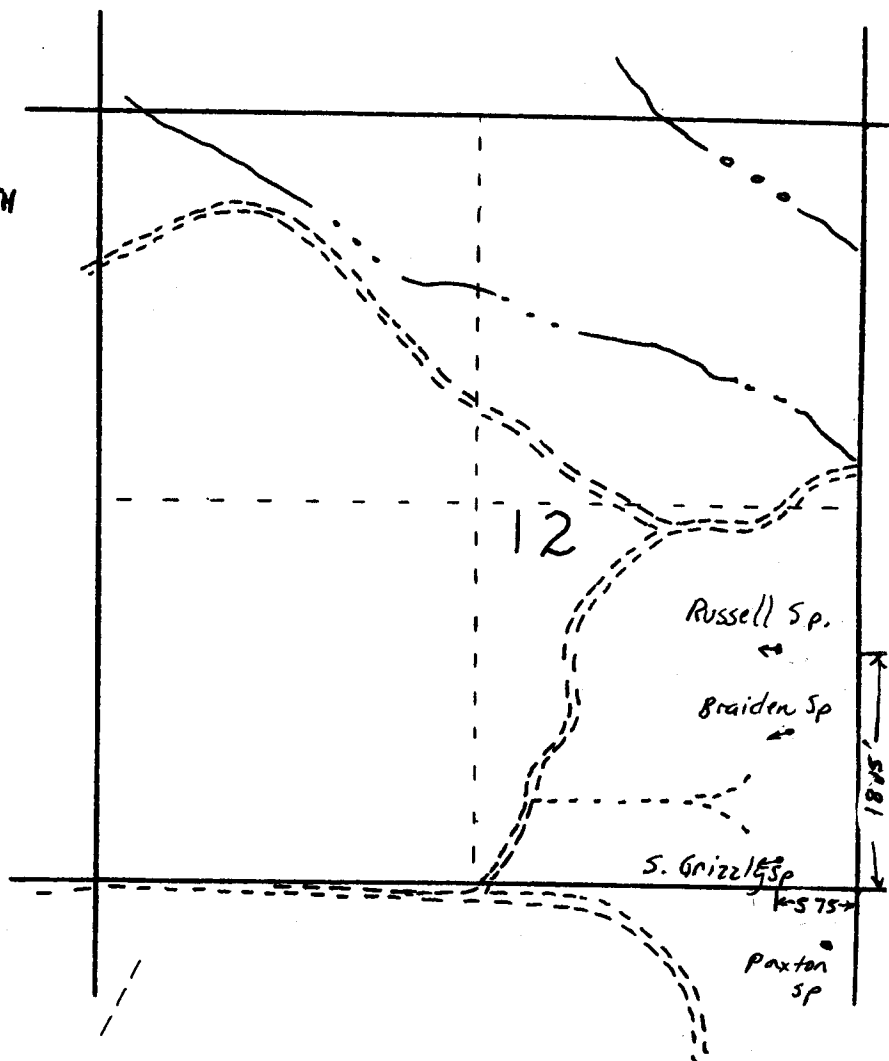

Application No. 66395
Permit No. 52379

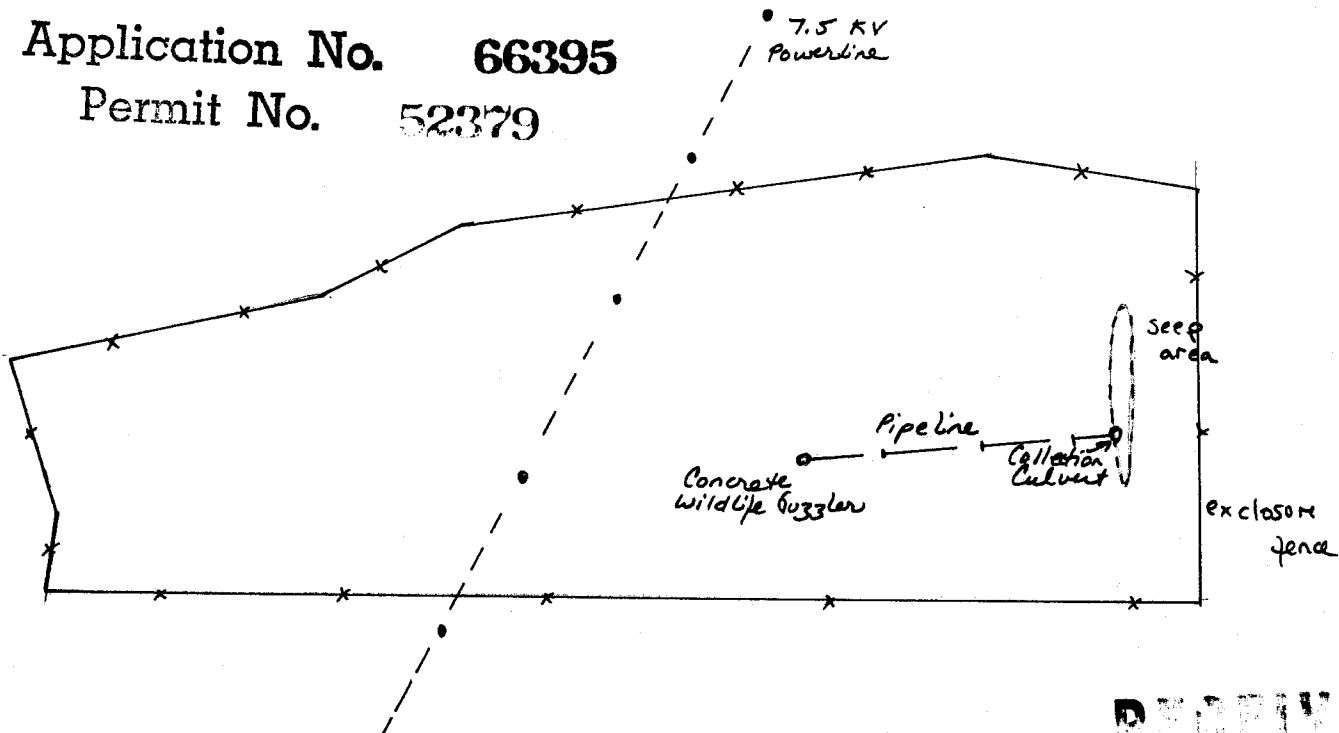

RECEIVED

SEP 19 1983
WATER RESOURCES DEPT.
SALEM, OREGON