


SCALE
4" = 1 mile

NORTH

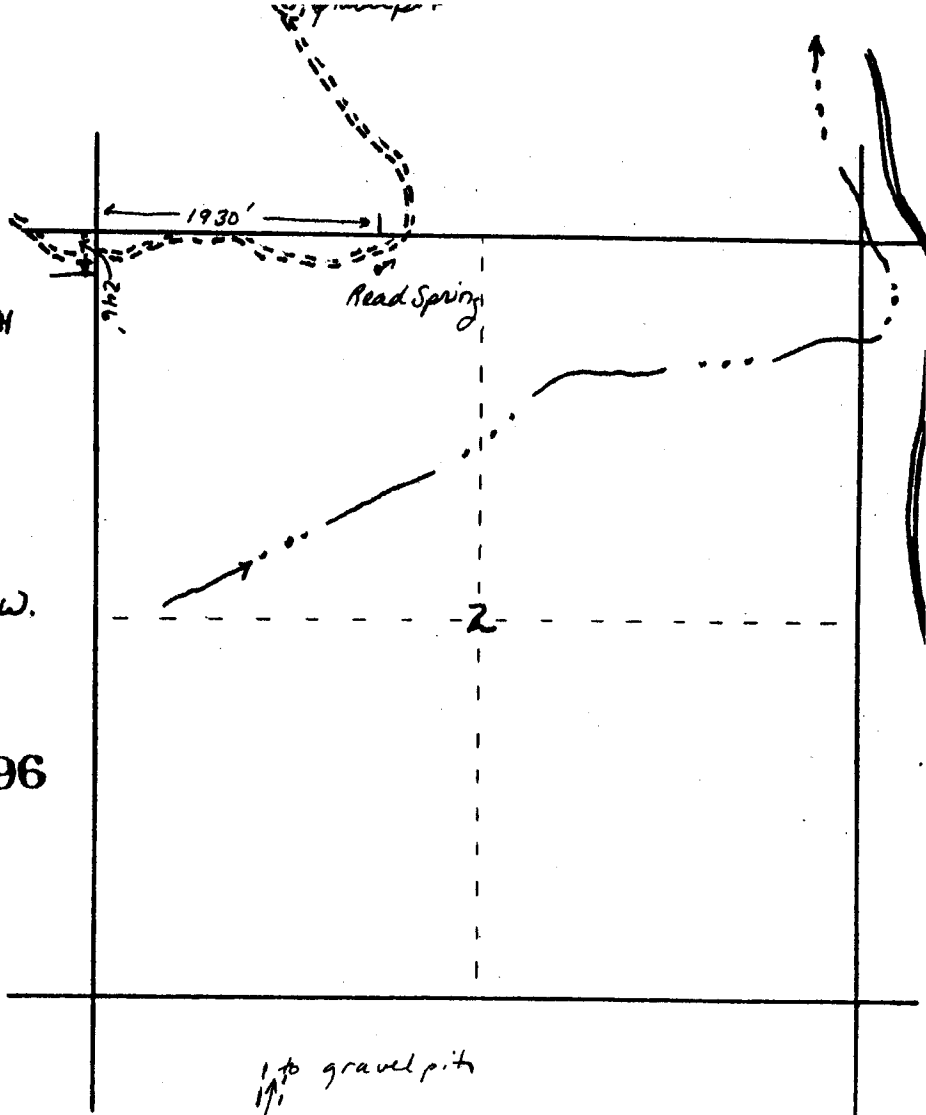

Read Spring

T. 13S., R. 13E.


Section 2, NE, NW.

Application No. 66396

Permit No. 52378

Diagram of Development

1" = 100'

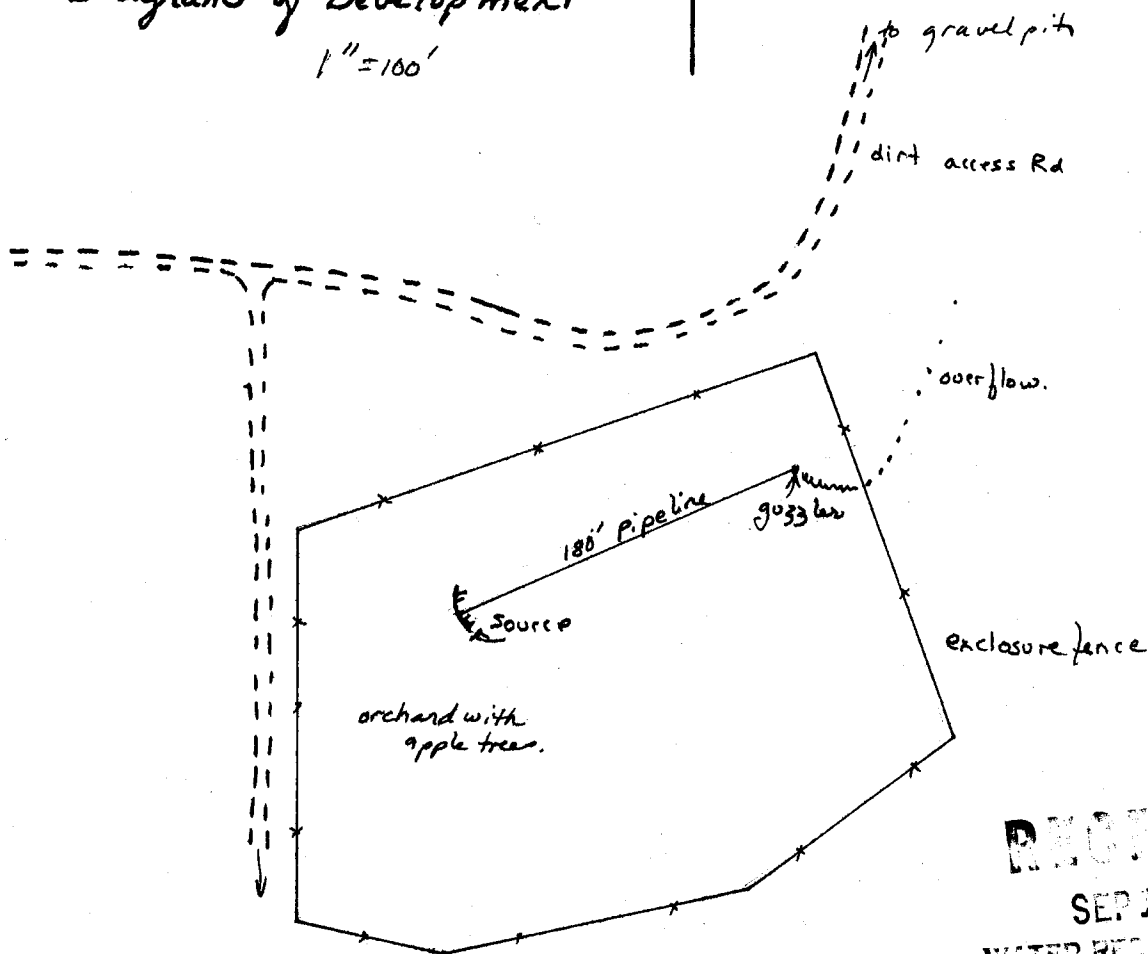

RECEIVED

SEP 19 1983
WATER RESOURCES DEPT.
SALEM, OREGON