


SCALE
4" = 1 mile

NORTH

West Springer Spring

T. 13 S., R. 13 E.

Section 1 NW, SW

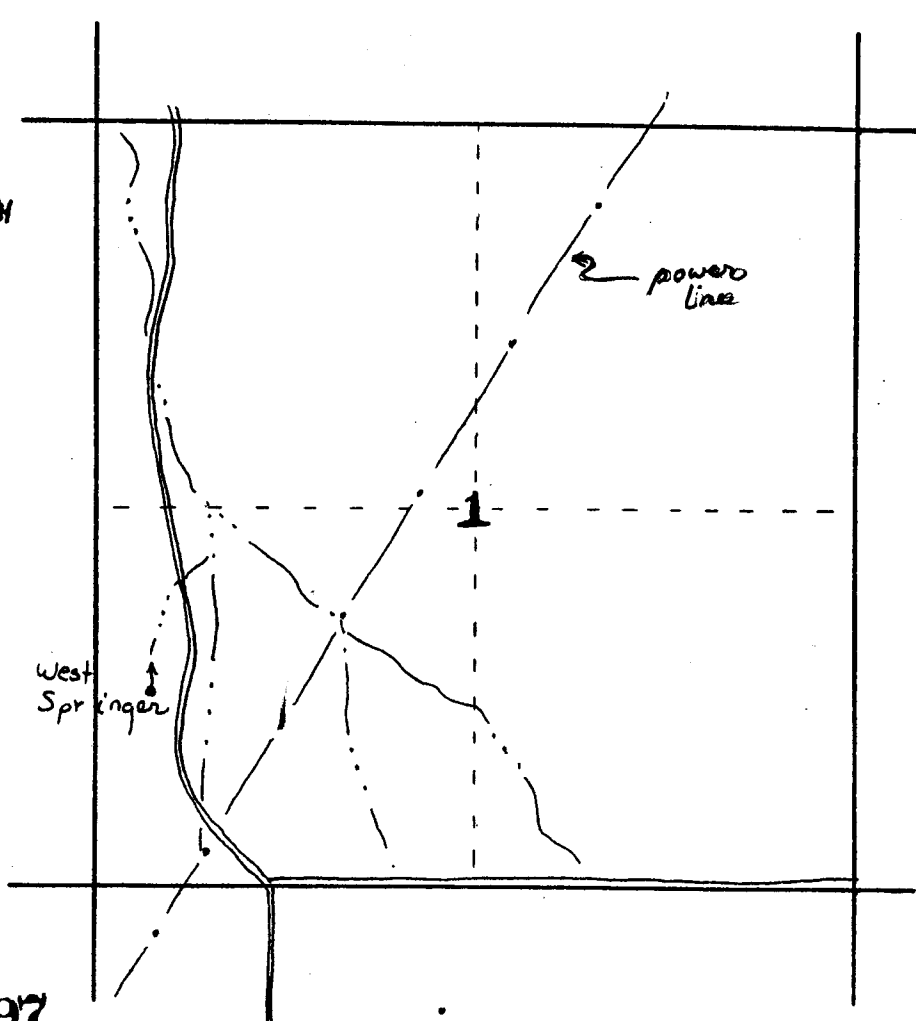


Application No.
Permit No.

66397

Diagram of Development

$\frac{3}{16}'' = 50'$

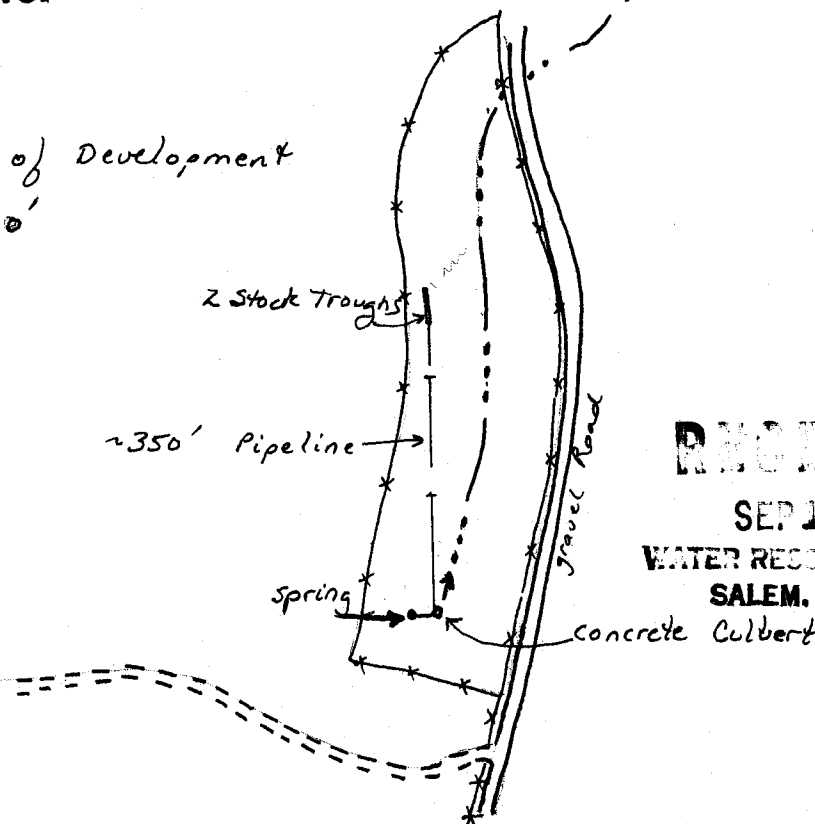

RECEIVED

SEP 19 1983

WATER RESOURCES DEPT.
SALEM, OREGON