


SCALE
4" = 1 mile

NORTH

Osborn Spring

T. 12S., R. 13E.


Section 34. SW, NW.

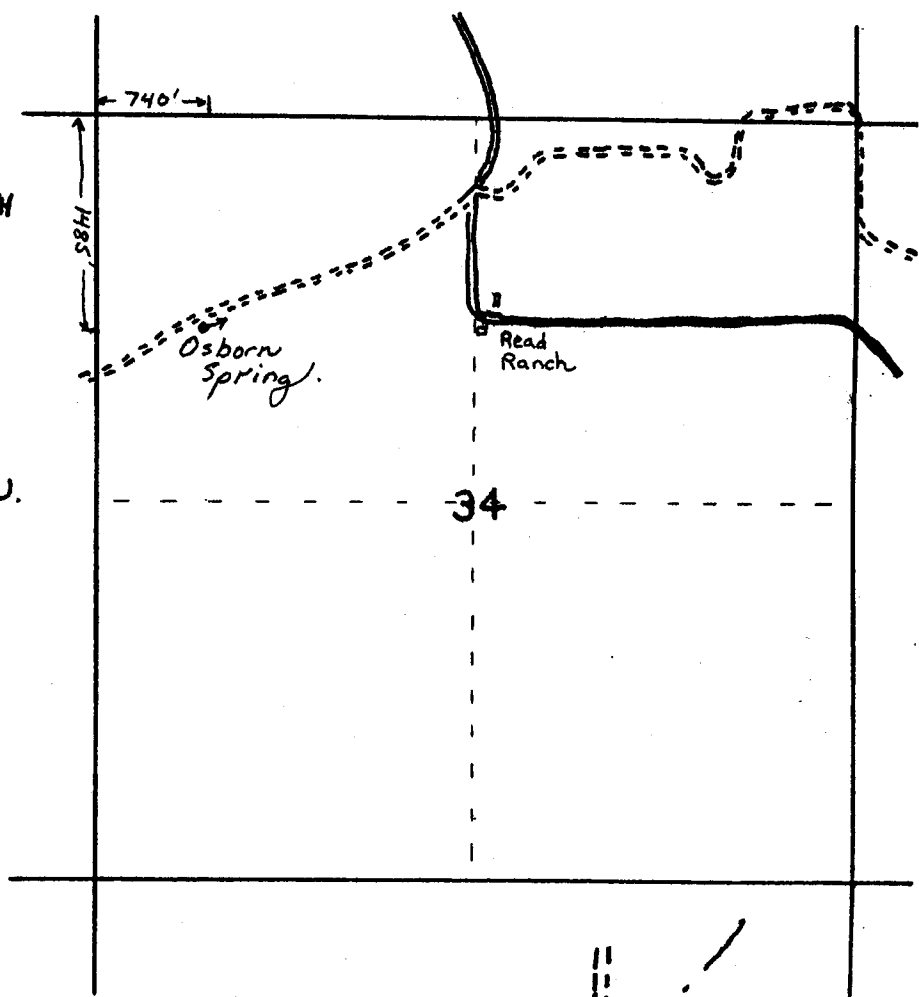

Application No. 66398

Permit No. 52376

Diagram of Development
1" = 300'

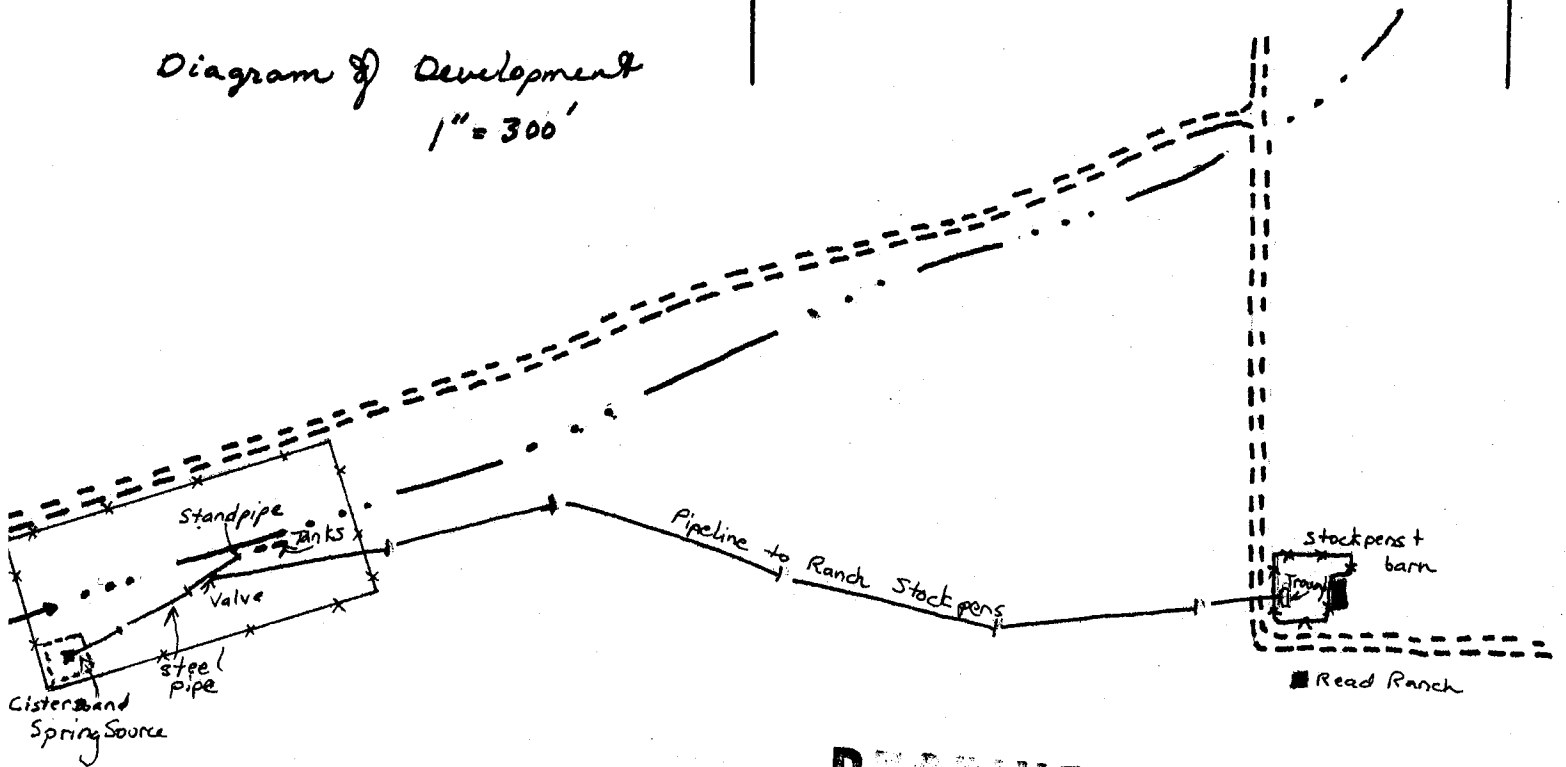

RECEIVED

SEP 19 1983

WATER RESOURCES DEPT.
SALEM, OREGON