

SCALE
4" = 1 mile
NORTH

Ridgeway Spring
T. 13 S., R. 14 E.,
Sec. 17. NE, SW.


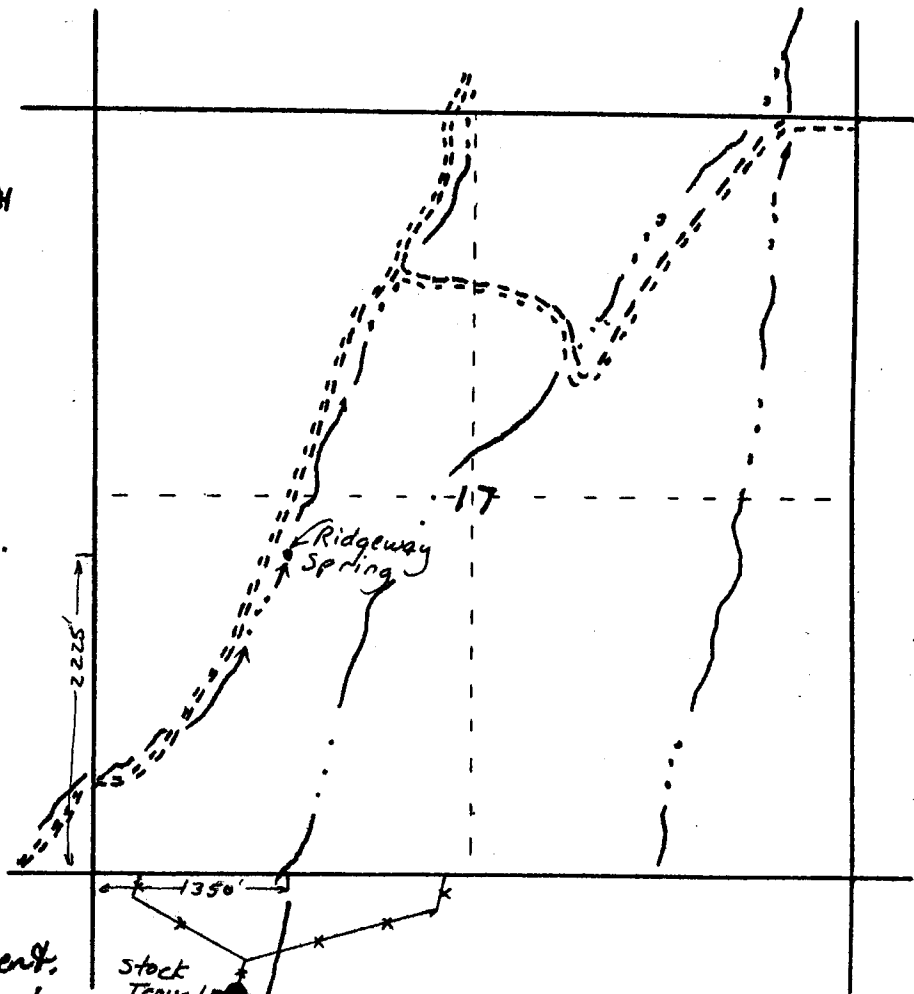


Diagram of Development.
1" = 50'

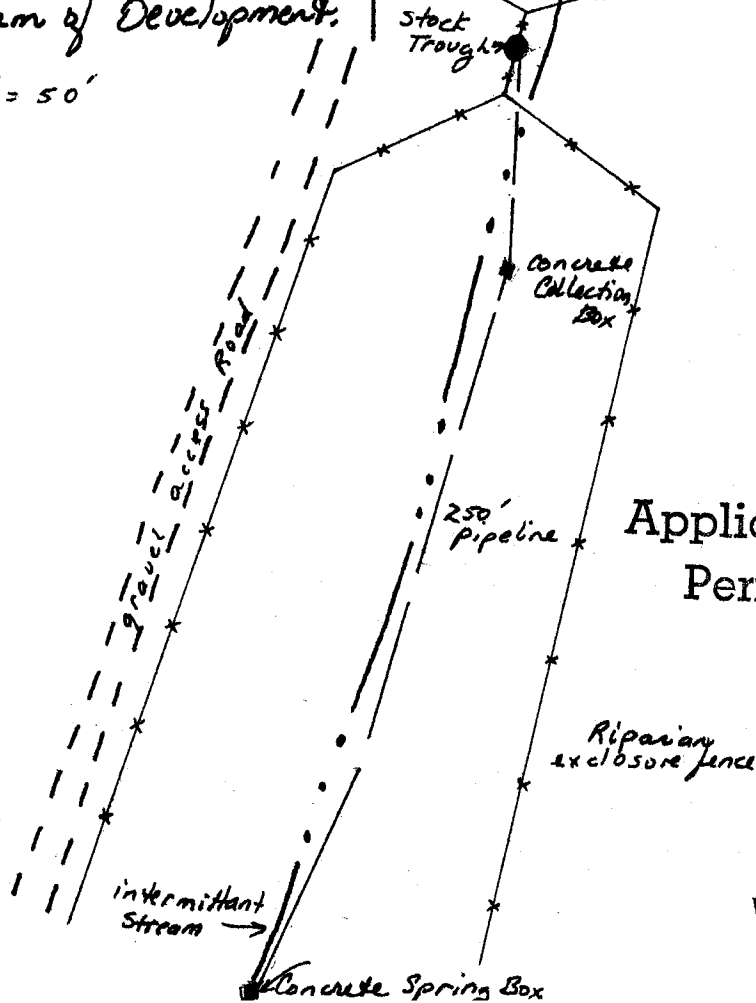

Application No. 66400
Permit No. 52373

RECEIVED

SEP 19 1983
WATER RESOURCES DEPT.
SALEM, OREGON