

SCALE
4" = 1 mile
NORTH

Upper Pine Ridge Spring
T. 13 S., R. 14 E., Sec 21
SE, SE


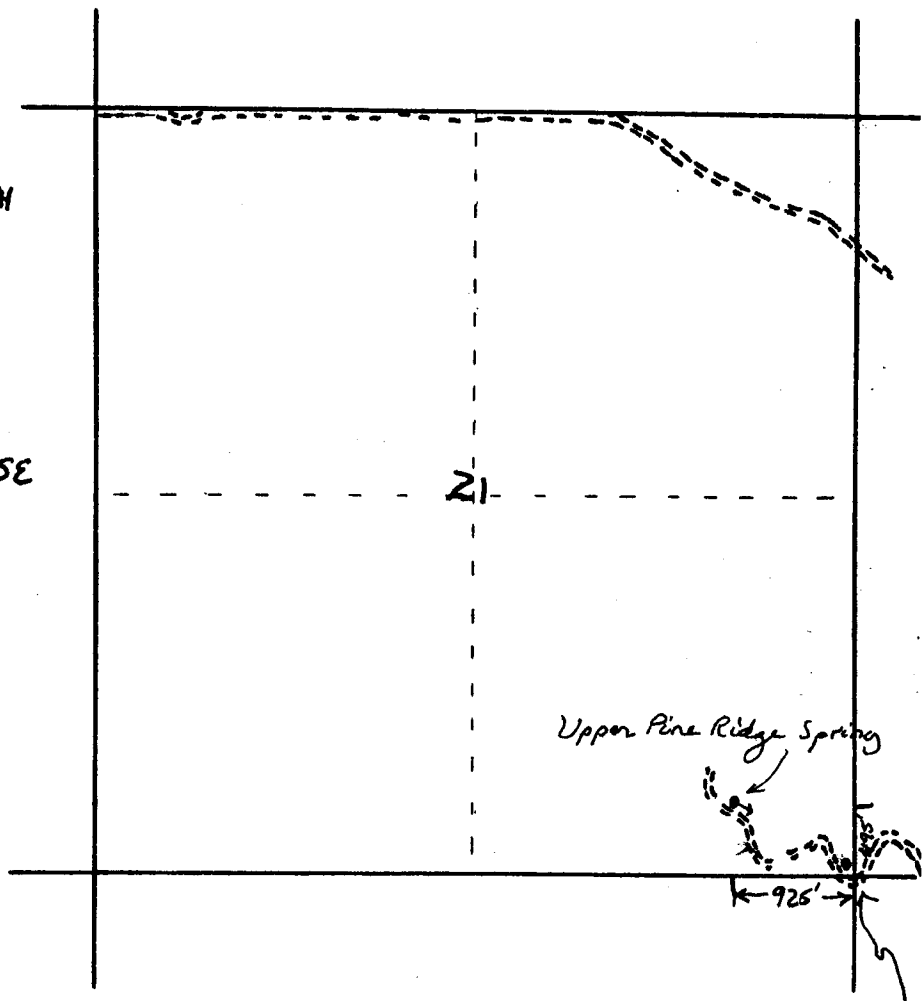


Diagram of Development.

1" = 50'
N

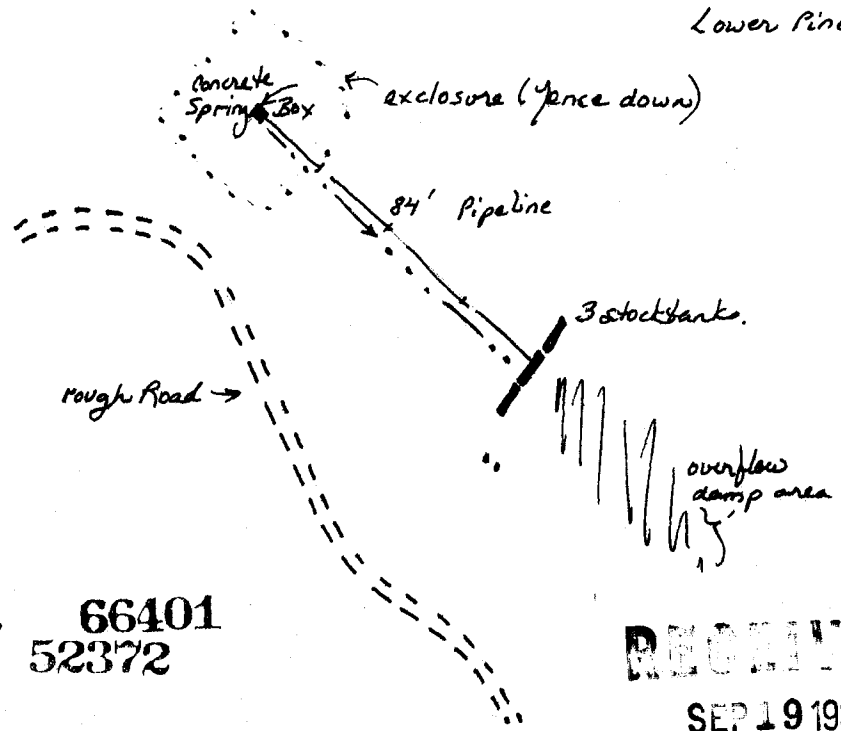

Application No. 66401
Permit No. 52372

RECEIVED
SEP 19 1983
WATER RESOURCES DEPT.
SALEM, OREGON

SCALE
4" = 1 mile
NORTH

Lower Pine Ridge Spring
T. 13 S., R. 14 E. Sec 21, SE. SE.

Application No. 66401
Permit No. 52372


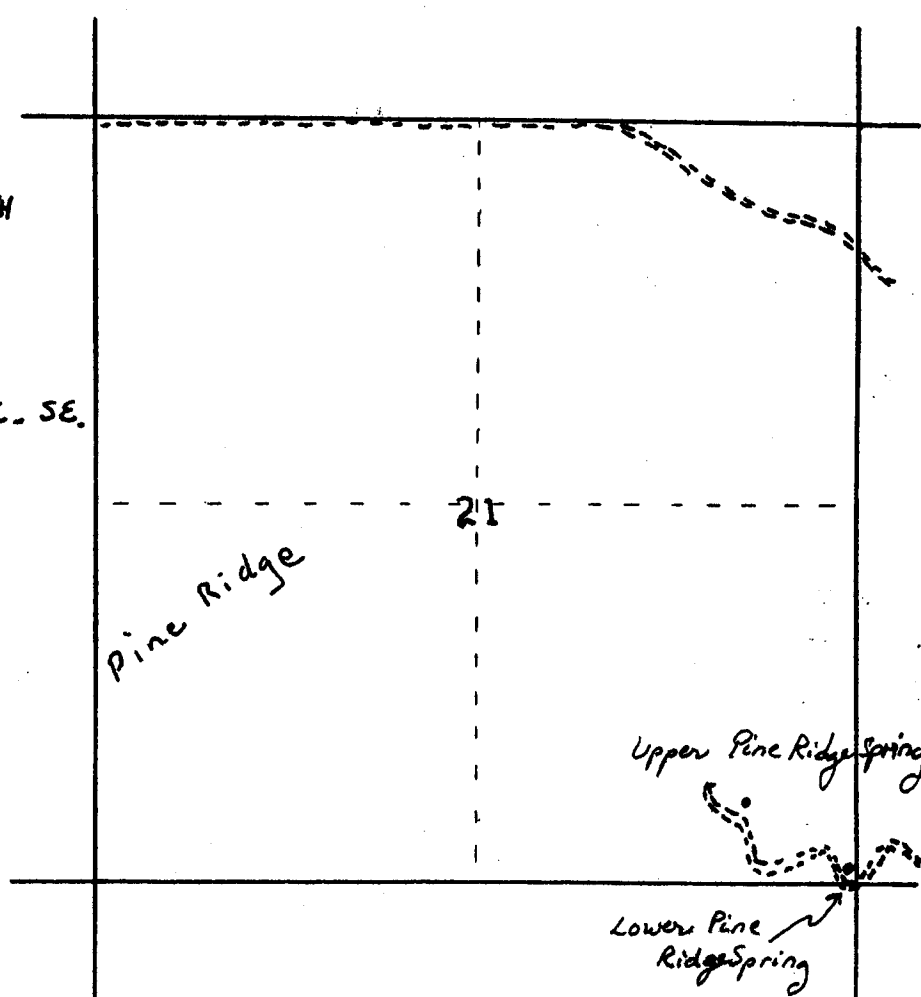


Diagram of Development.
1" = 100' ↑ N

Upper Pine Ridge Spring
Lower Pine Ridge Spring
200' North from SE corner
200' West from SE corner.

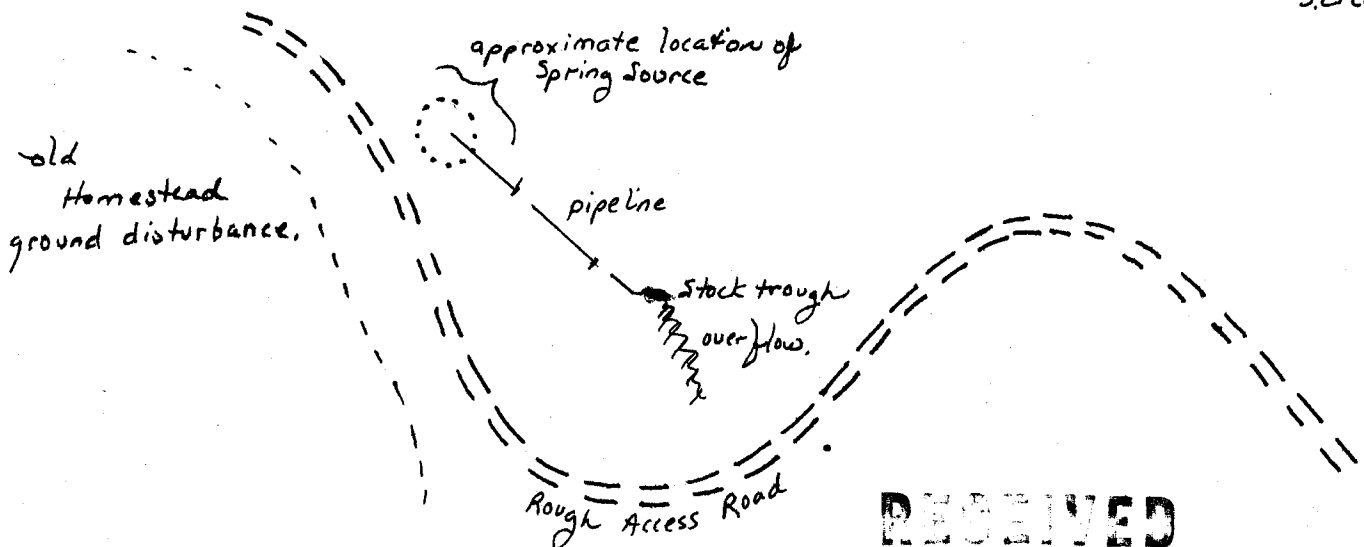

RECEIVED

SEP 19 1983
WATER RESOURCES DEPT.
SALEM, OREGON