

SCALE
4" = 1 mile

NORTH

McCain. Stackyard Spring

T. 13 S., R. 14 E., Sec. 19

NE, NE.


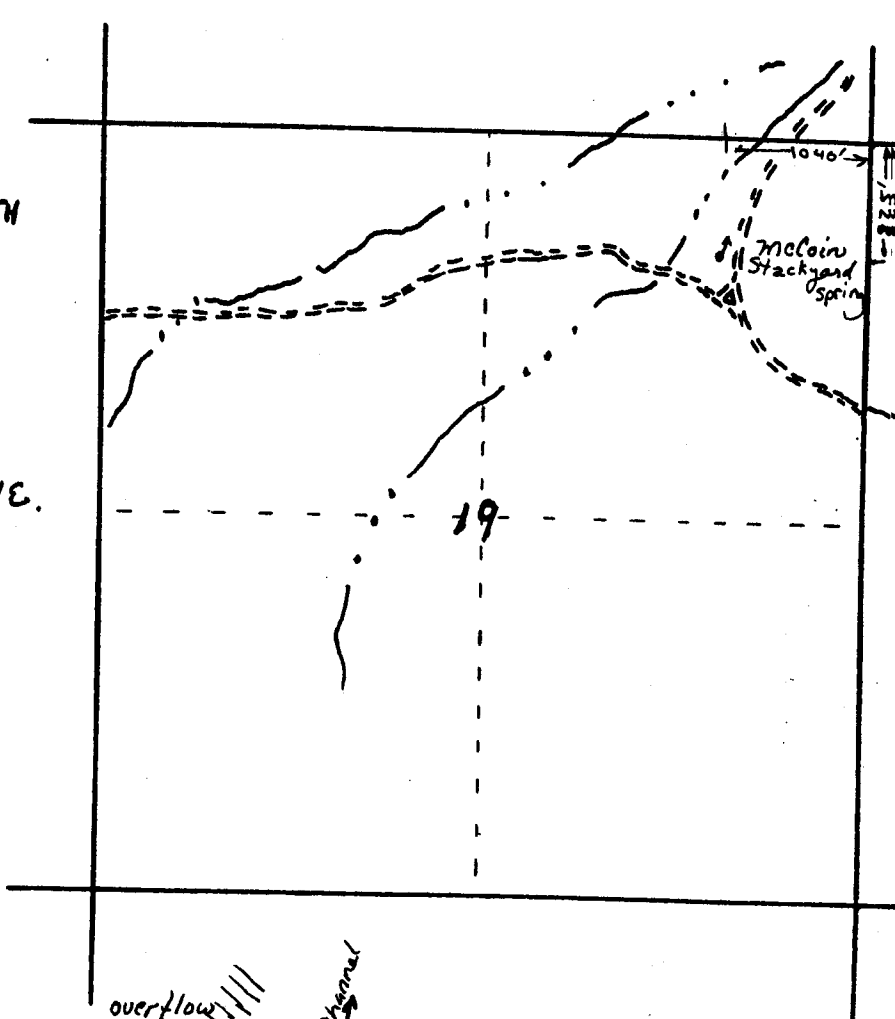


Diagram of Development.

1" = 100'

Application No. 66402

Permit No. 52371

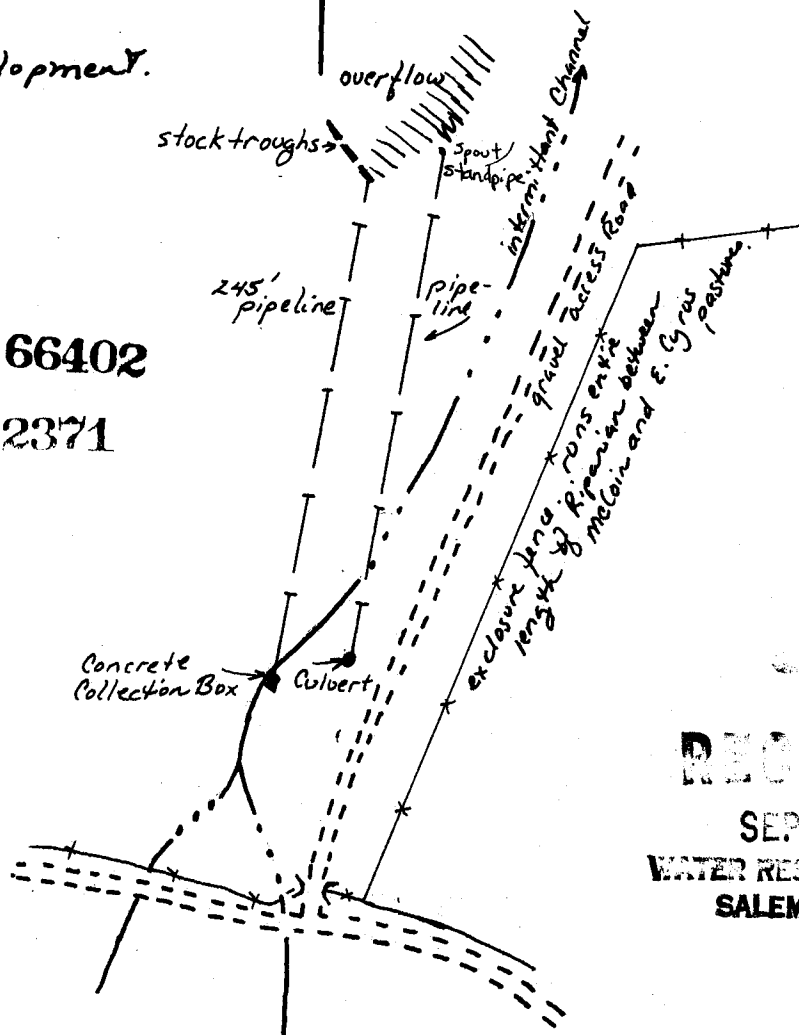

RECEIVED

SEP 19 1983

WATER RESOURCES DEPT.
SALEM, OREGON