

SCALE
4" = 1 mile

NORTH

Rock Spring.


T. 13 S., R. 14 E., Section 17

SW, SE

Application No. 66403
Permit No. 52370

Diagram of Development

1" = 50'

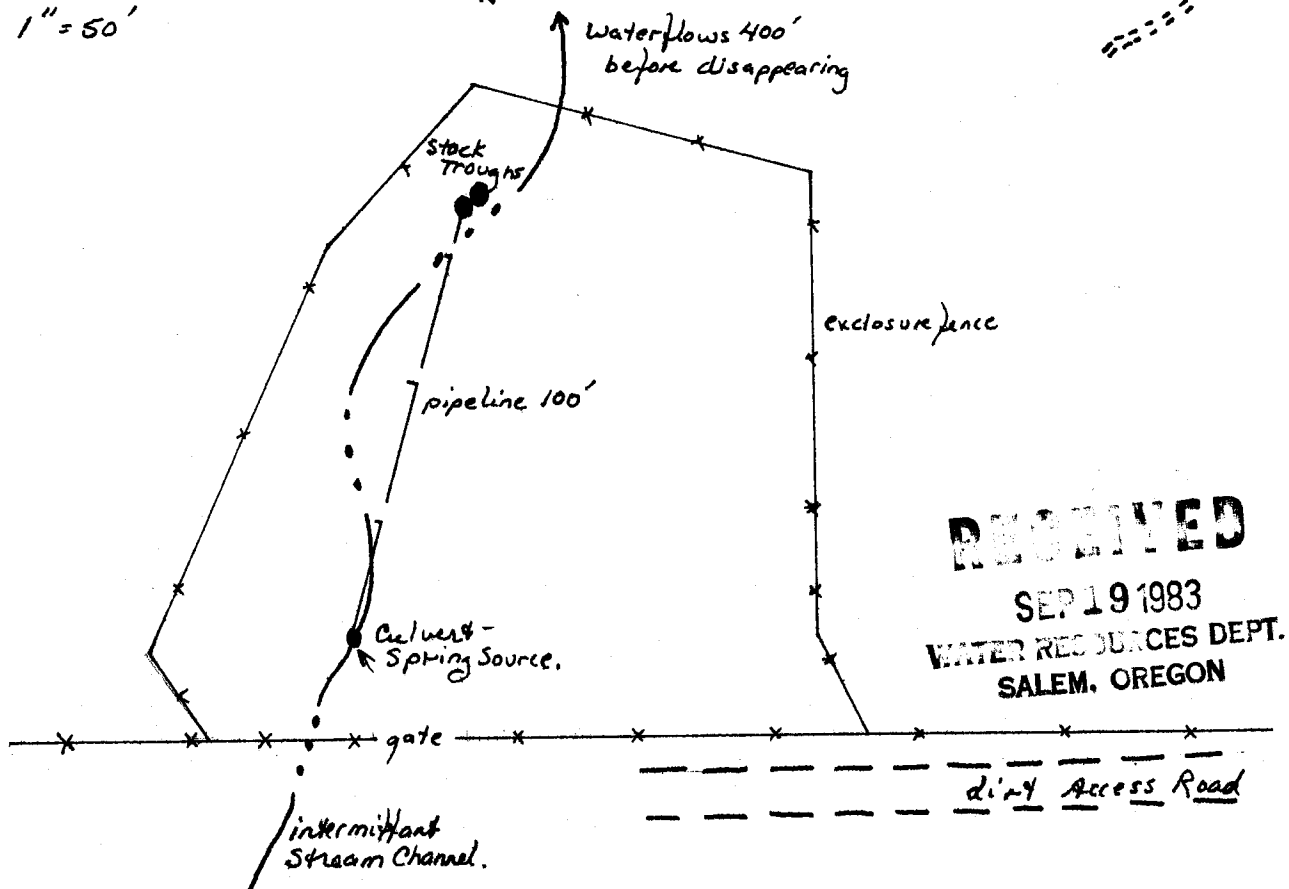

RECEIVED

SEP 19 1983
WATER RESOURCES DEPT.
SALEM, OREGON