



SCALE
4" = 1 mile
NORTH

McCoin Orchard Spring
T. 13 S., R. 14 E.
Section 20 SW, NW

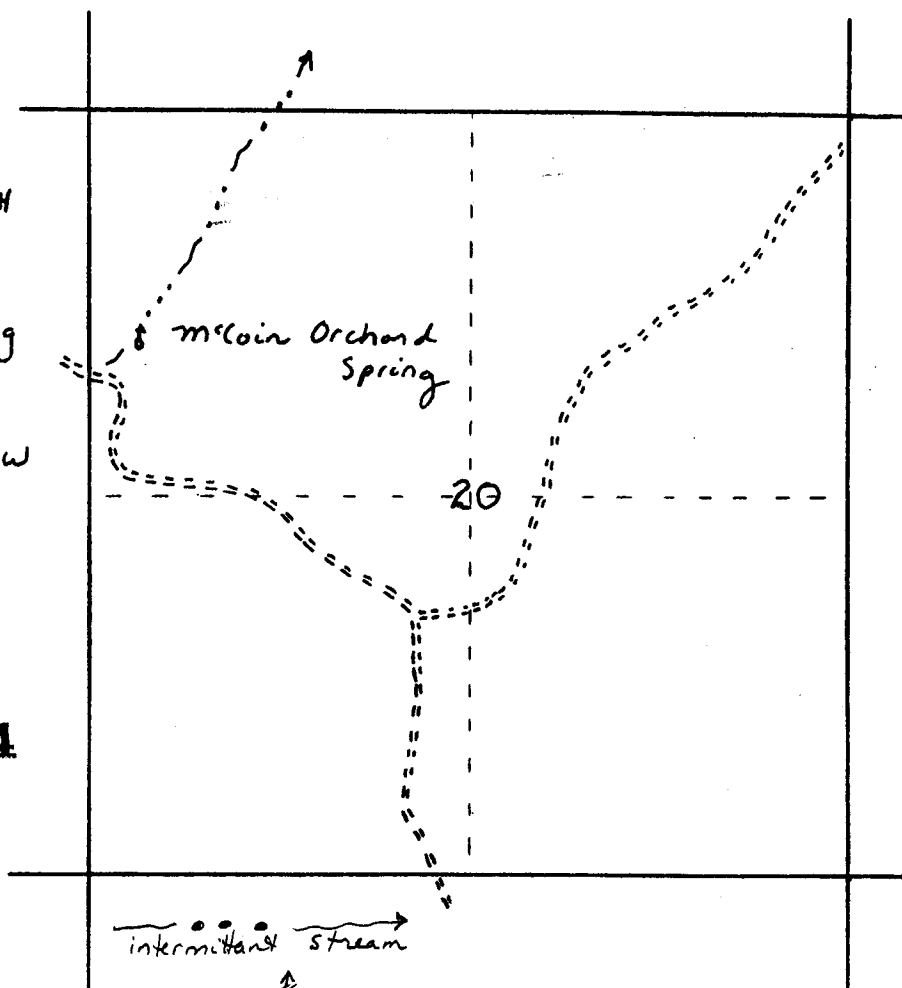

Application No. 66404
Permit No.

Diagram of Development
1 inch = ~25 feet

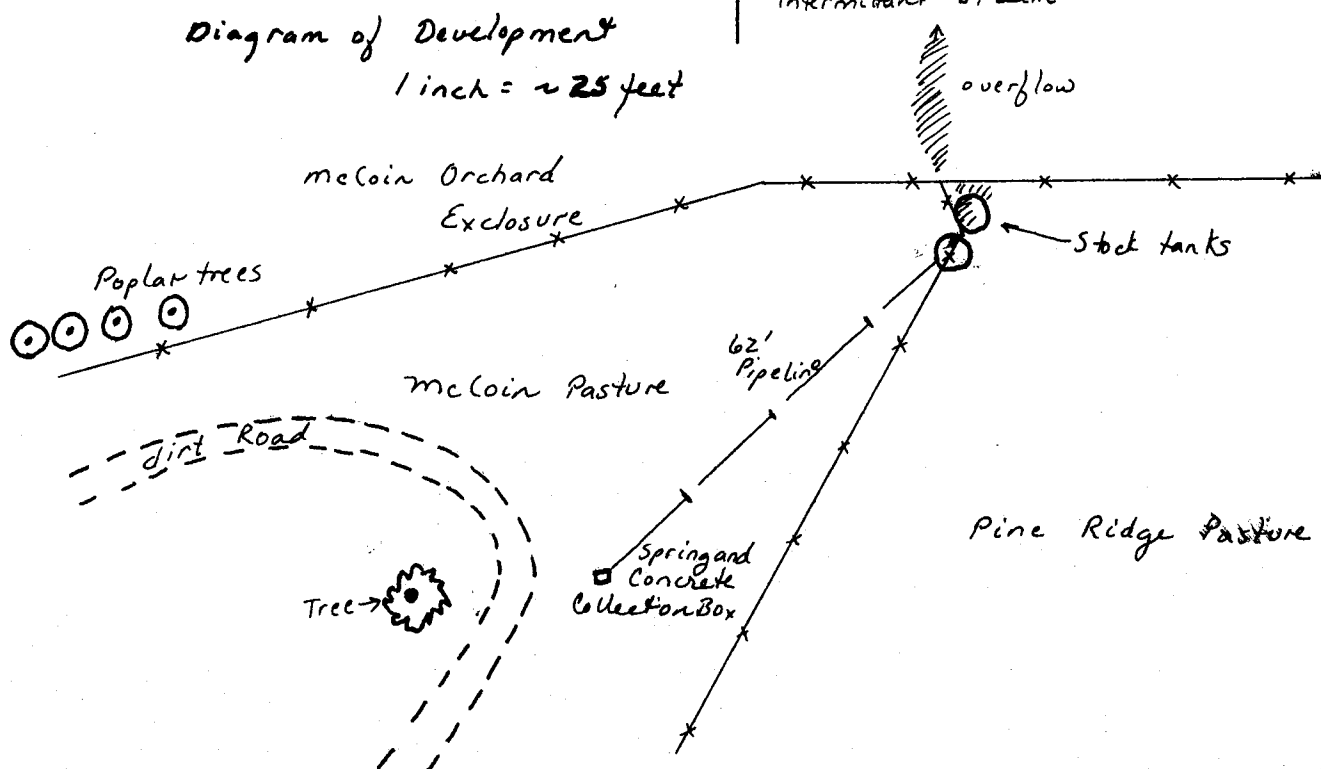

RECEIVED

SEP 19 1983
WATER RESOURCES DEPT.
SALEM, OREGON