

SCALE
4" = 1 mile

NORTH

Upper Keckler Spring

T. 13 S., R. 13 E.,

Section 25 NW, SE.

25

Upper Keckler
Spring

Rd. Closed

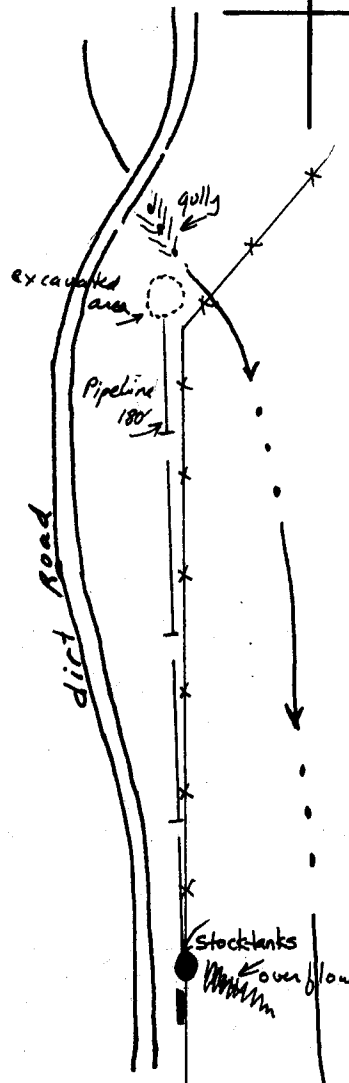


Diagram of Development

1" = 50'

N

Application No. 66406

Permit No.

RECEIVED

SEP 19 1983

WATER RESOURCES DEPT.
SALEM, OREGON