


Upper Skull Hollow Spring # 1

T. 13 S., R. 14 E. Section 29

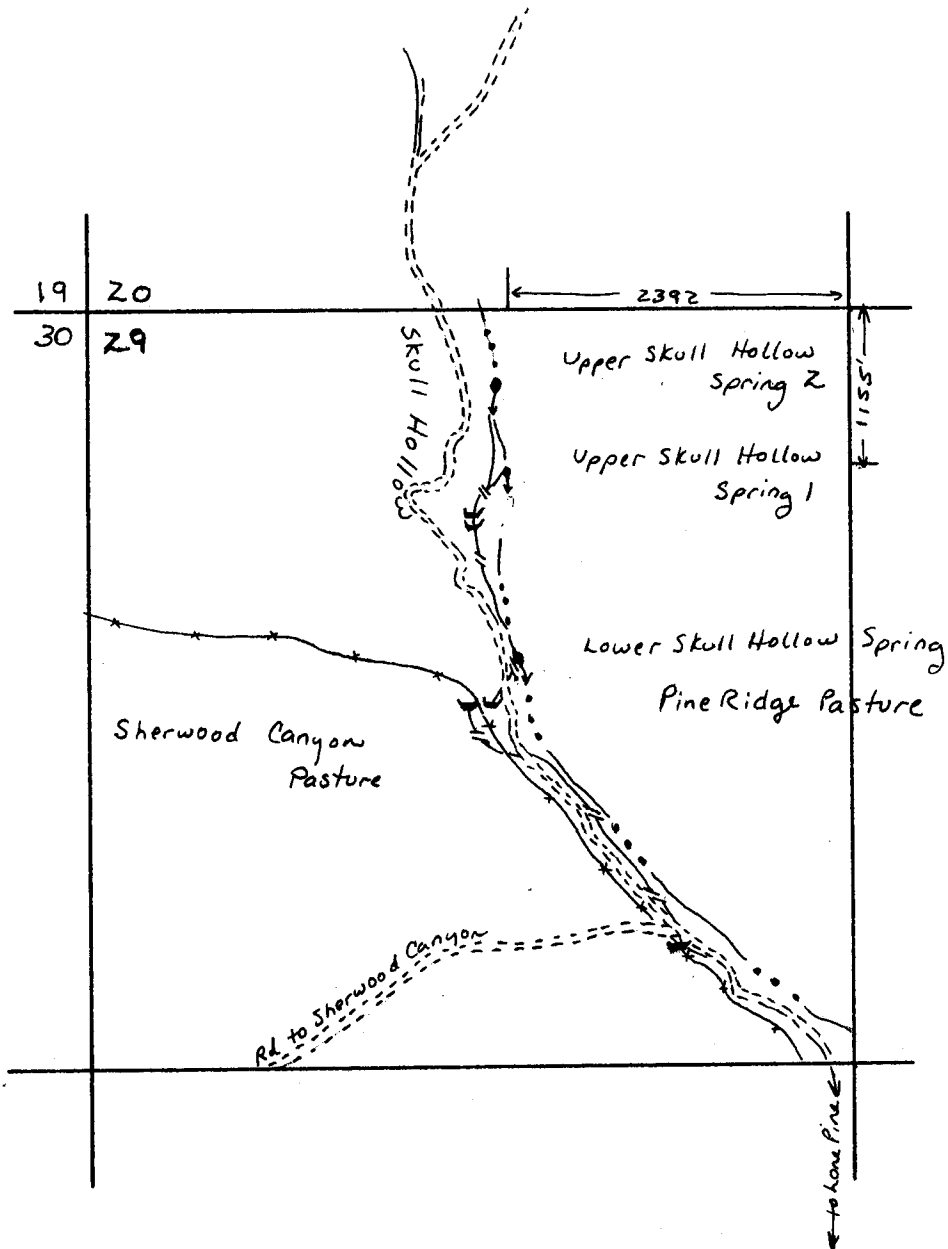

Application No. 66407
Permit No. 52366


SCALE
4" = 1 MILE



RECEIVED
SEP 19 1983
WATER RESOURCES DEPT.
SALEM, OREGON

Upper Skull Hollow Spring # 2

T. 13 S., R. 14 E. Section 29

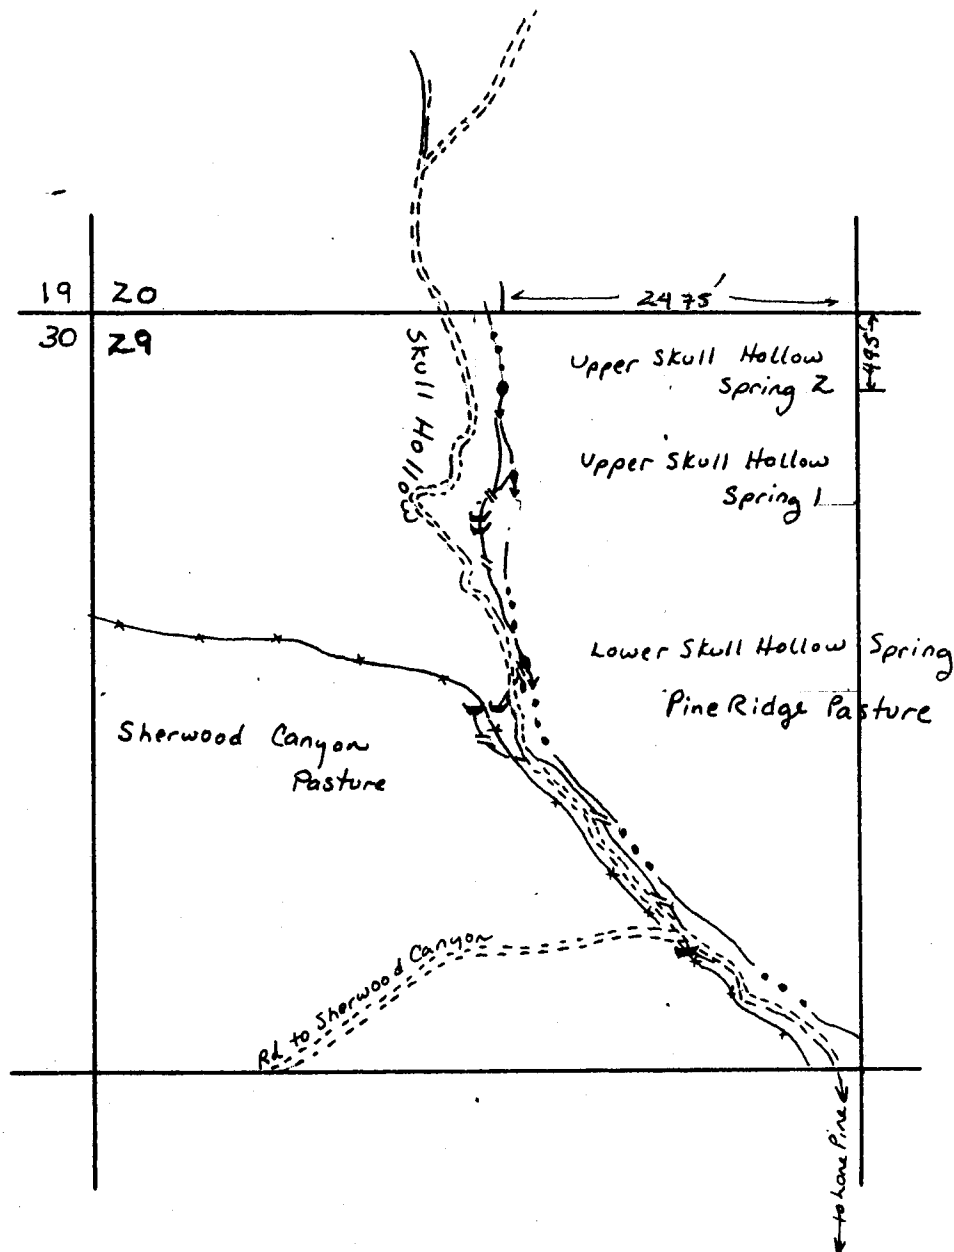

Application No. 66407
Permit No. 52366


SCALE
4" = 1 MILE



RECEIVED
SEP 19 1983
WATER RESOURCES DEPT.
SALEM, OREGON

Lower Skull Hollow.

T. 13 S., R. 14 E. Section 29

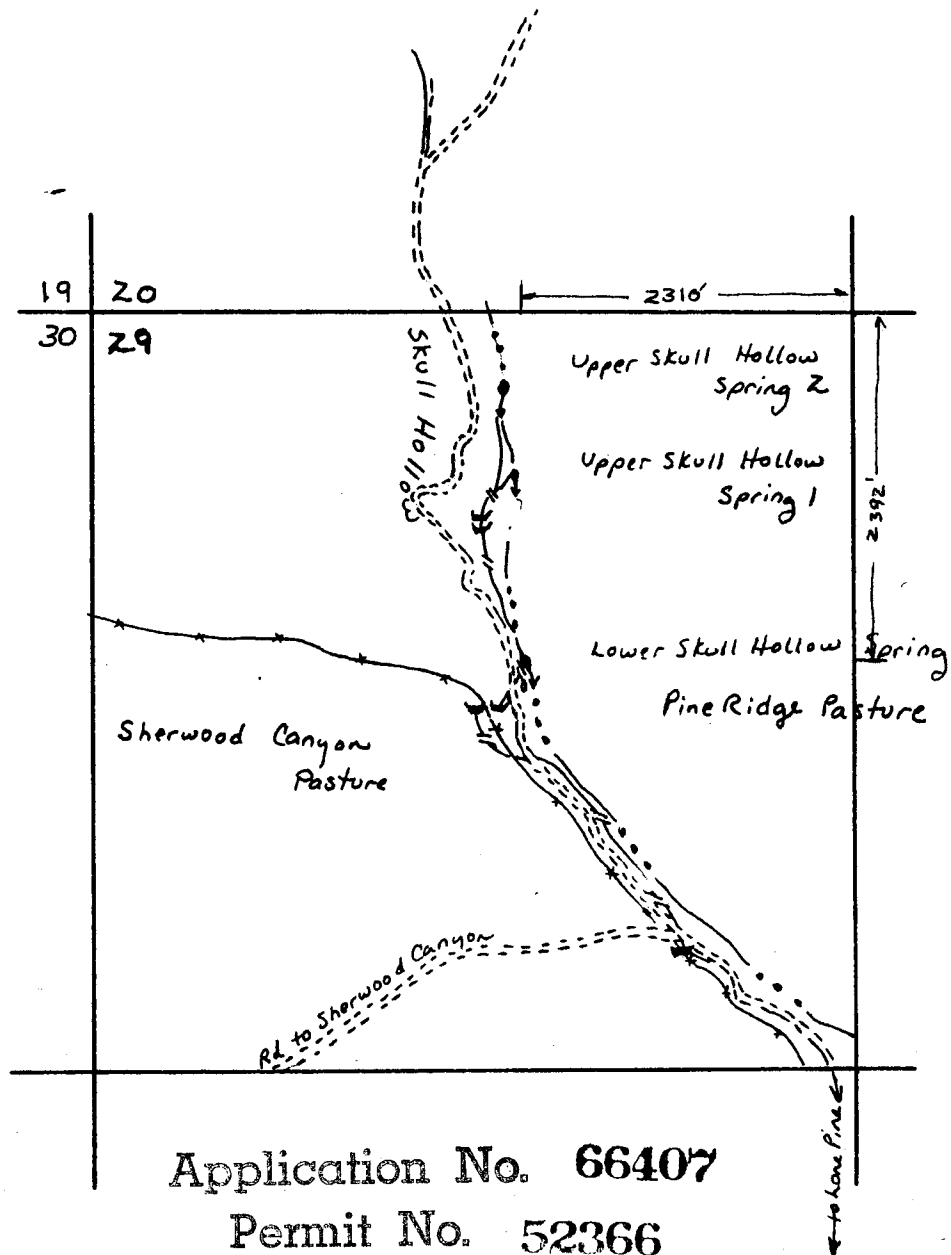

Application No. 66407

Permit No. 52366

SCALE
4" = 1 MILE




RECEIVED

SEP 19 1983

WATER RESOURCES DEPT.
SALEM, OREGON

Skull Hollow Spring System
T. 13S., R. 14E., Section 29,

Scale 6" = 2640'

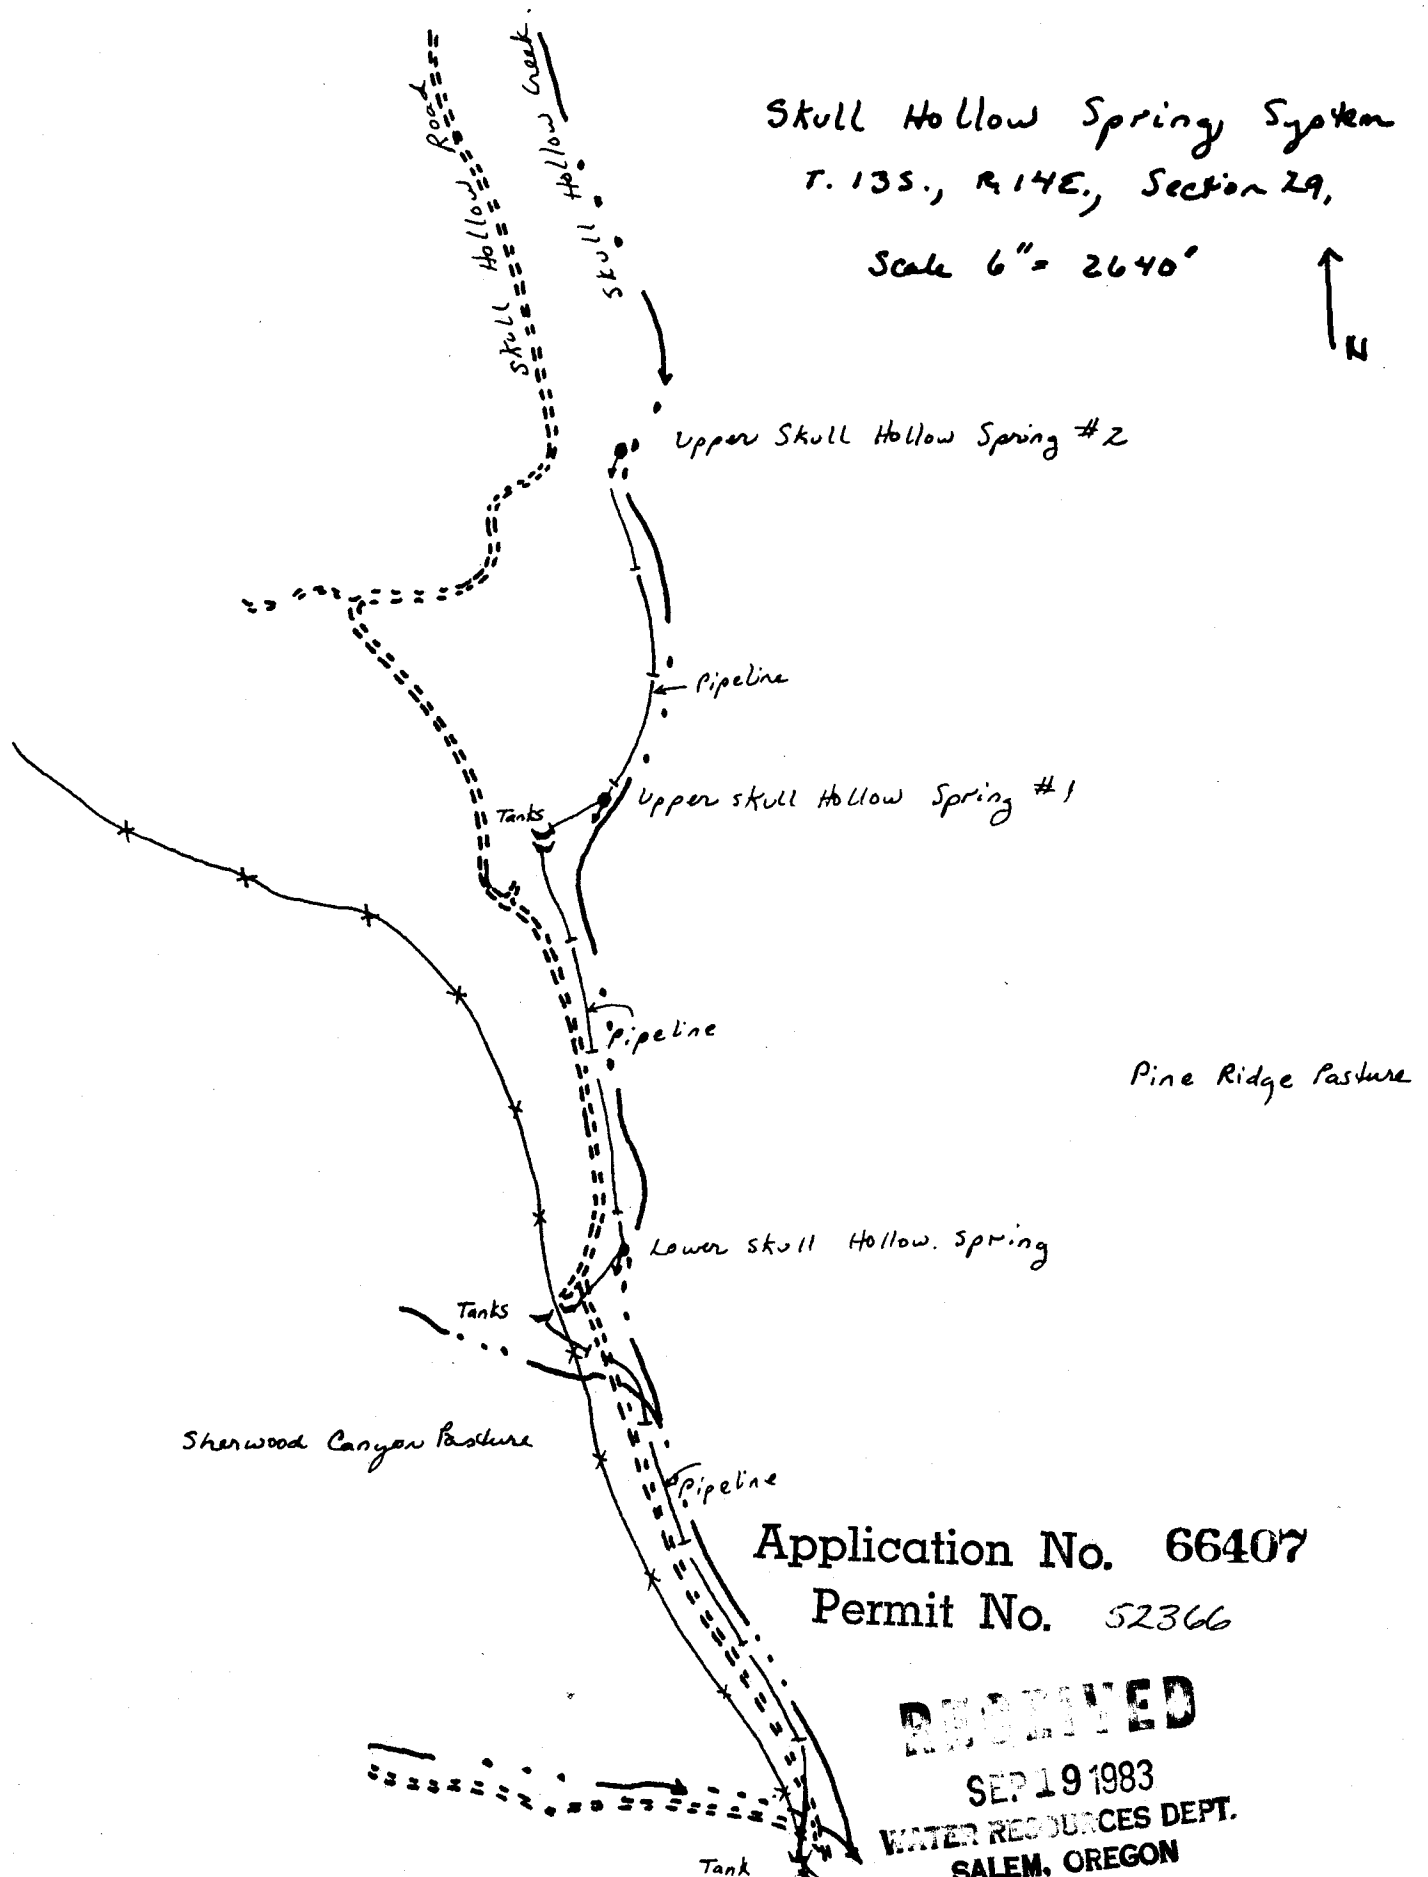

Application No. 66407

Permit No. 52366

RECEIVED

SEP 19 1983
WATER RESOURCES DEPT.
SALEM, OREGON