

SCALE
4" = 1 mile

NORTH

East Springer Spring
T. 13, S., R. 13 E.,
Section 1 SW, SW


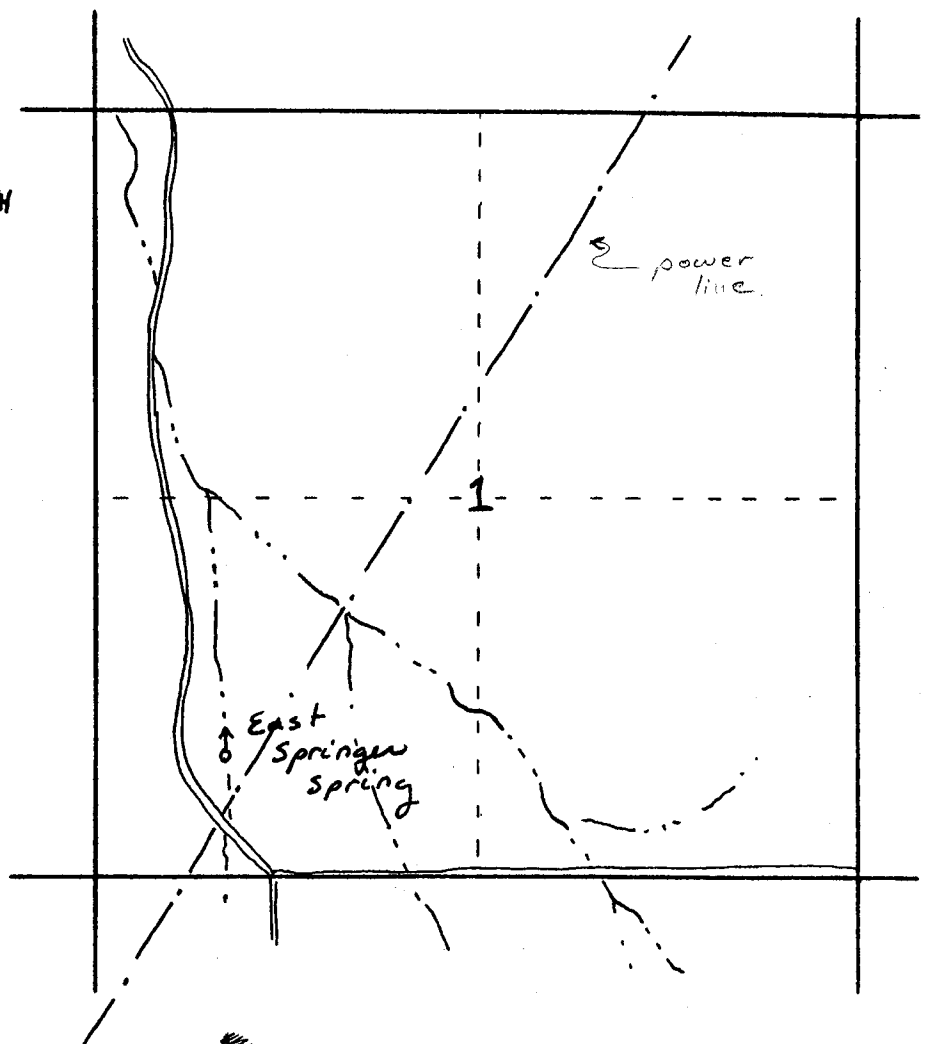


Diagram of Development
Scale 1" = ~100 ft.

Application No. 66408
Permit No. 52365

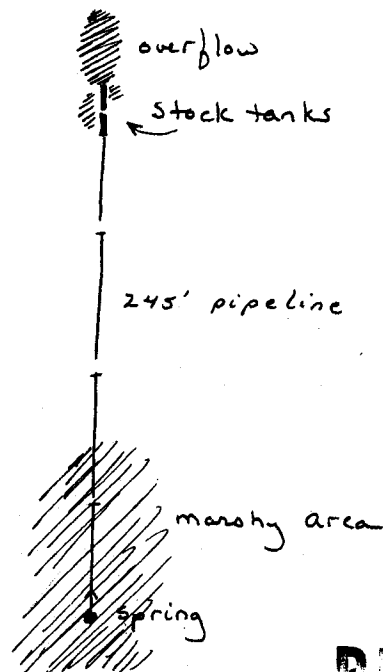

RECEIVED

SEP 19 1983
WATER RESOURCES DEPT.
SALEM, OREGON

NORTH

Section 1 SW $\frac{1}{4}$, SE $\frac{1}{4}$

Permit No. 52365

Diagram of Rodman Spring Water development
1" = ~50'

RECEIVED

SEP 19 1983

WATER RESOURCES DEPT.
SALEM, OREGON

riparian fencing continues
along most of this section
of the X

Windom-Rodman drainage System

175' Pipeline

concrete
spring box

wooden stock tank

dirty Road