
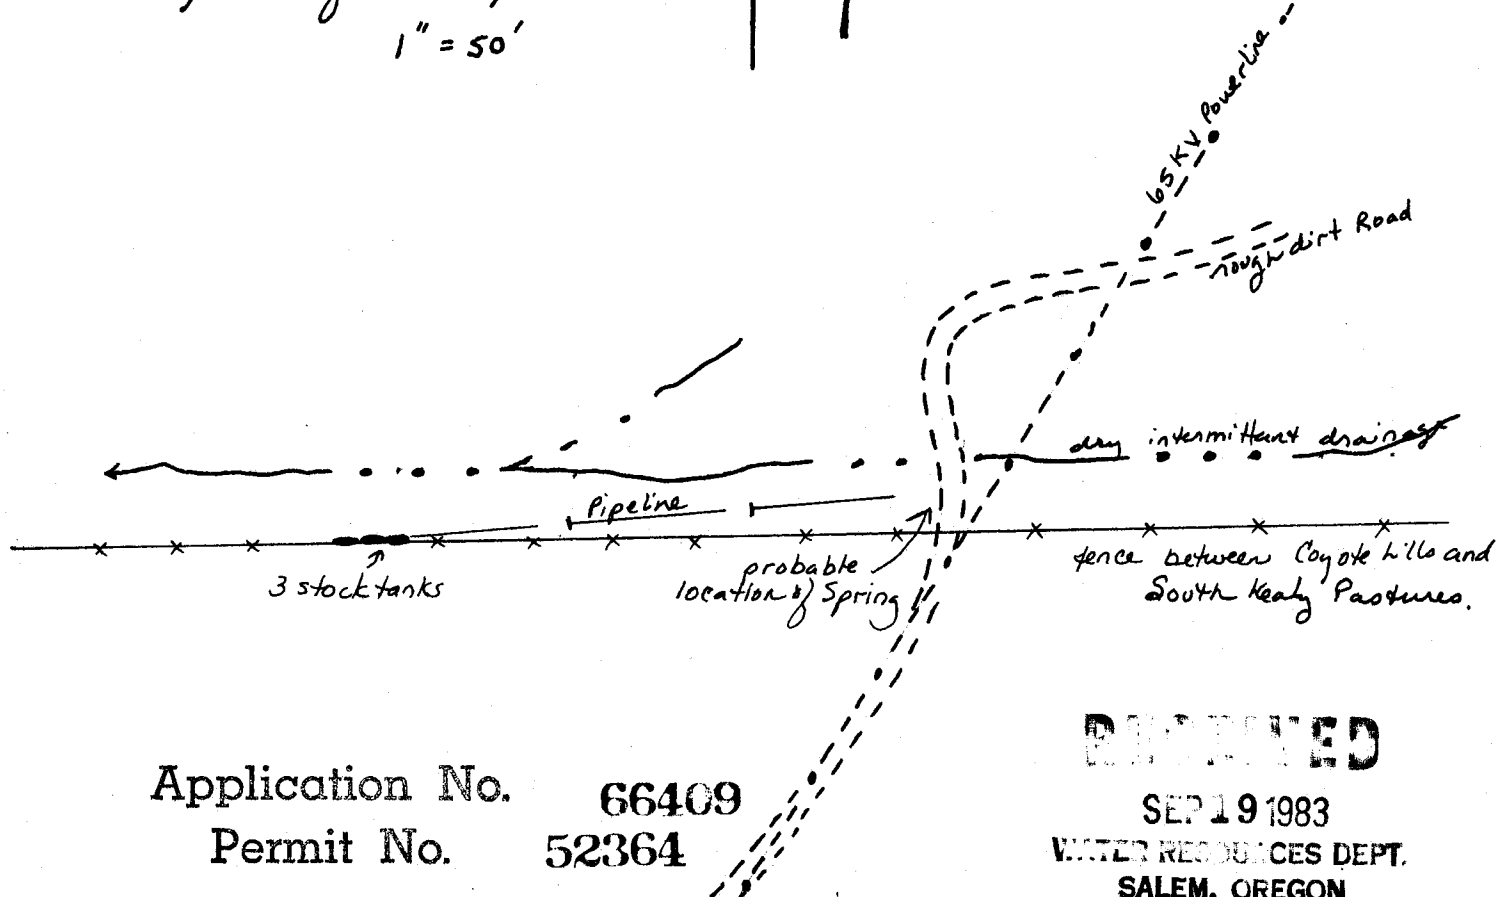


SCALE
4" = 1 mile
NORTH

Robey Spring
T. 12S., R. 13E.,
Section 36 SE, SE.

Diagram of Development
1" = 50'

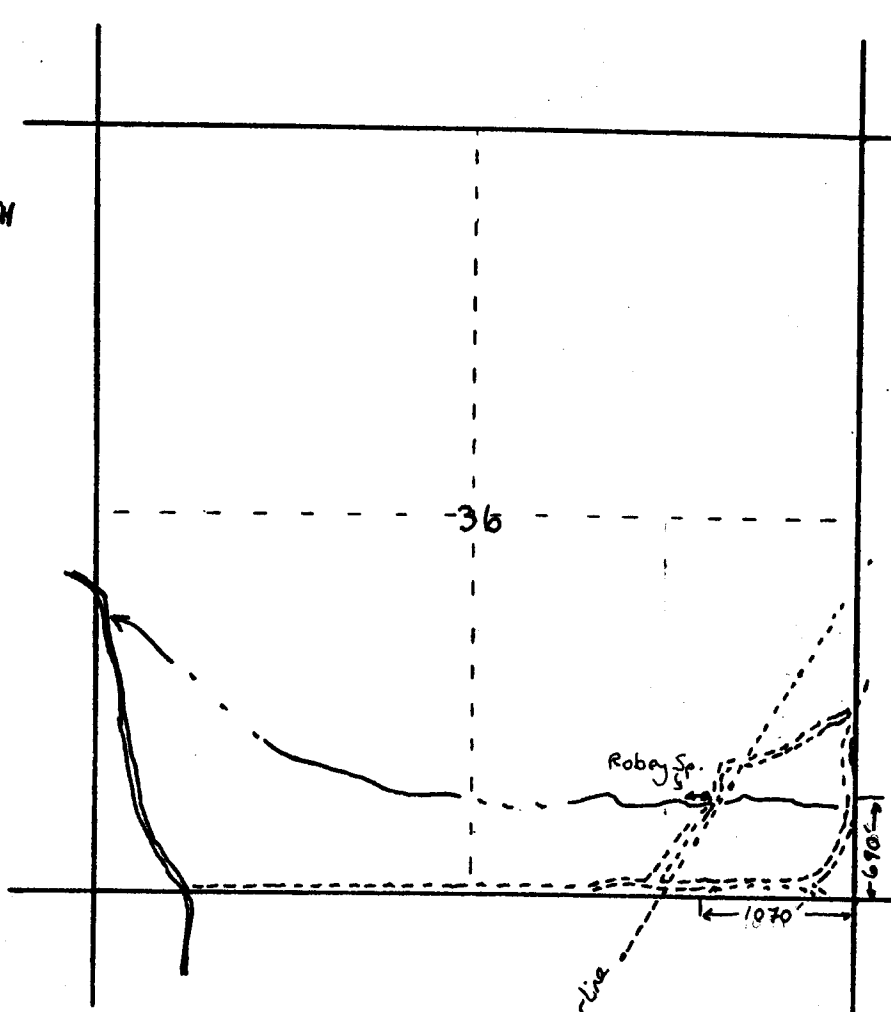

Application No. 66409
Permit No. 52364

RECEIVED
SEP 19 1983
WATER RESOURCES DEPT.
SALEM, OREGON