



T.5S. & 6S., R.5.W, W.M

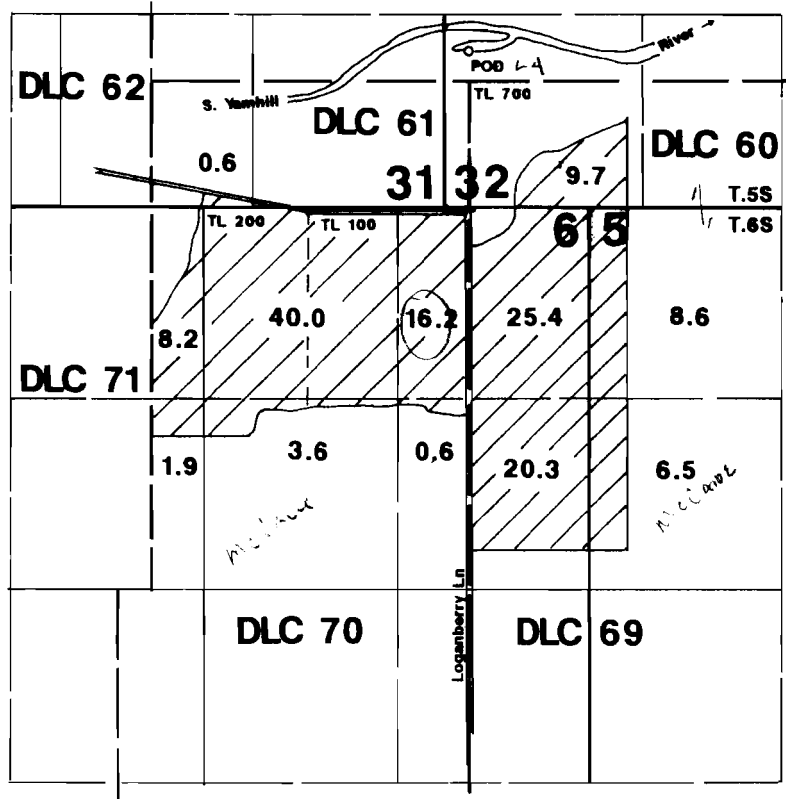

1" = 1320'

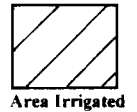

POD is located 200'N of NW corner of McCune DLC 60.

Final Proof Survey

In Name Of

C.M. Morris Jr. & Michael M. Morris

Application #: 63202

Permit #: 46693

Surveyed on April 26, 2002 by JM Schuette

This Map Was Prepared For The Purpose Of Identifying The Location Of A Water Right Only And Is Not Intended To Provide Legal Dimensions Or Location Of Property Ownership Lines.

