

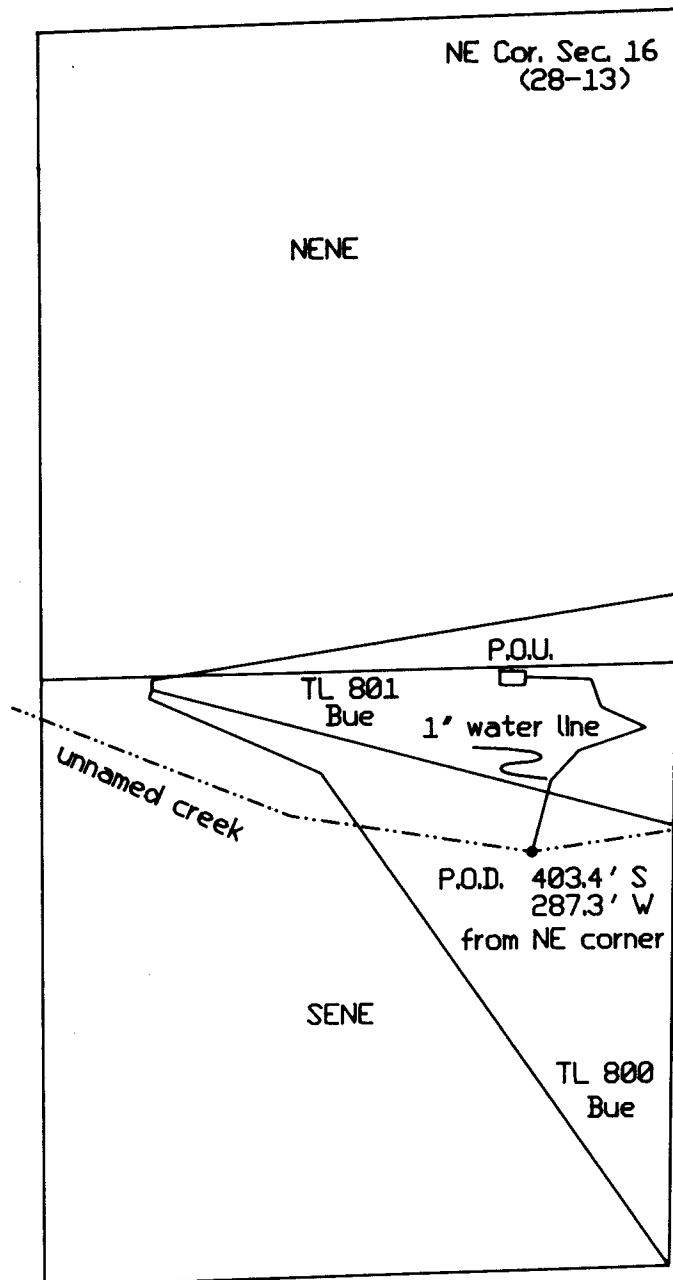


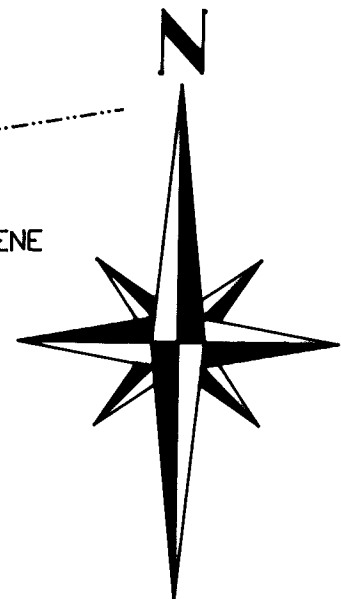

RECEIVED

JUN - 3 2003

WATER RESOURCES DEPT.
SALEM, OREGON

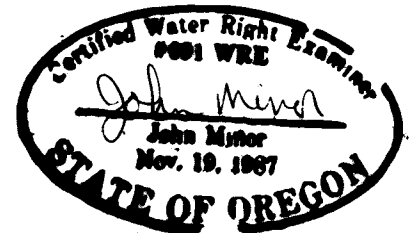

Final Proof Survey
App. S-69567 Permit S-50382
In the name of Pete Bue
Located in
SENE Sec. 16, T.28S., R.13W., W.M.

Scale: 1" = 400'
The purpose of this map is to
identify the location of the
water right. It is not intended
to identify property ownership
lines. Final proof survey
performed May 21, 2003.