



SE1/4SE1/4 Section 34, T.35 S., R.4 W., W.M.

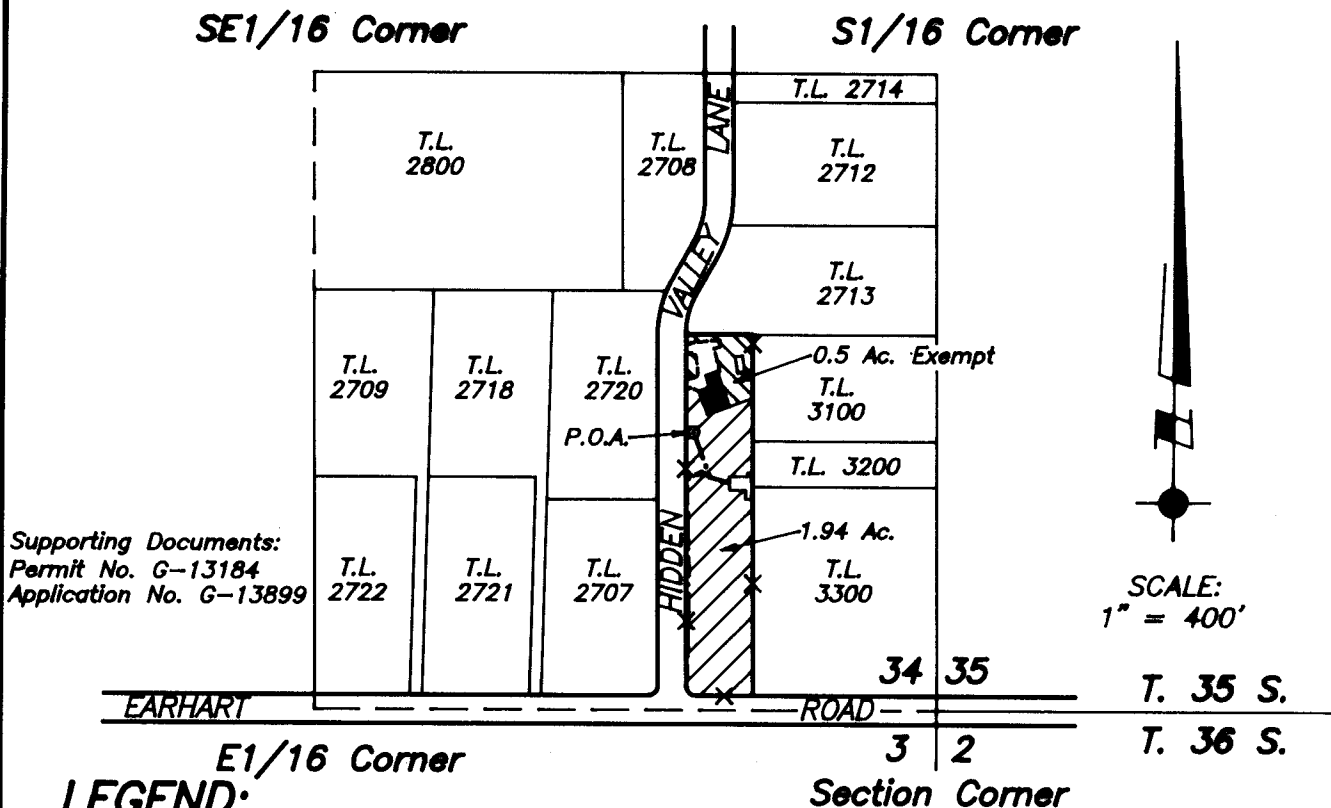


LEGEND:

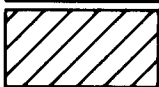

Authorized Place of Use for Irrigation (1.94 Acres)
per Permit No. G-13184 (Priority Date = November 30, 1994)




Place of Use of Exempt lawn and noncommercial garden
(0.5 Acres)

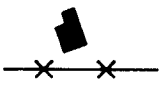


Existing House



Existing Building

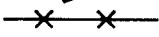

Wire Fence

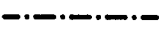

Existing Underground 2" PVC Pipeline

P.O.A. Existing Well = Point of Appropriation
(581 feet North and 518 feet West of the S.E. Corner of Section 34)

This plat was prepared for the purpose of identifying the location of the water right only. There is no intent to provide dimensions or locations of property ownership lines.

Ties to the point of appropriation and area of use are based upon measurements made to found monuments per Survey No. 4562. Survey ties were made using a Wild T-1600 Theodolite and a Distomat DI-1600.

A 3 page site report accompanies this plat.

PS \gomborg\gomborg.dwg


Subject Property: T.L. 2706, Map No. 35-4W-34

PROJECT NO.
404-94-294

DRAWING NO.
82-8.5.11

DATE
Sept. 27, 2001

SCALE
1" = 400'

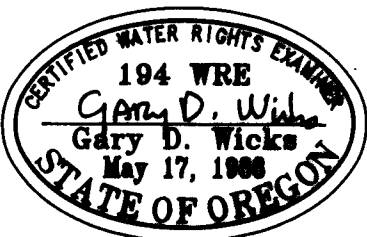

PLAT FOR CLAIM OF BENEFICIAL USE

LOCATED IN
SE1/4 SE1/4 Section 34, T.35 S., R.4 W. W.M.
Jackson County, Oregon

PREPARED FOR:

WILLIAM R. GOMBERG
44 Hidden Valley Lane
Rogue River, Oregon 97537
Tel. (541) 582-3750

SURVEYED BY:

WICKS ENGINEERING & SURVEYING
311 N.E. "D" Street
Grants Pass, Oregon 97526
Tel. (541) 479-3436

RECEIVED

OCT 01 2001

WATER RESOURCES DEPT.
SALEM, OREGON