


RECEIVED

SEP 24 1986

WATER RESOURCES DEPT.
SALEM, OREGON

SECTION 12

TOWNSHIP 10S RANGE 45E W.M.

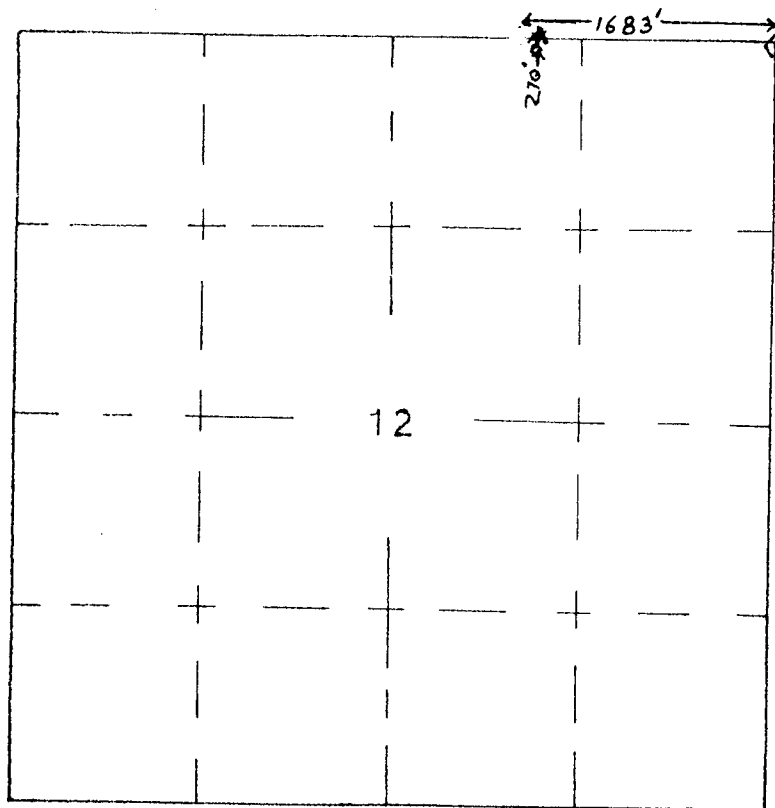

Application No. 68927

Permit No. 52406

RECEIVED

SEP 2 1986

WATER RESOURCES DEPT.

SALEM, OREGON

U. S. DEPARTMENT OF THE INTERIOR
BUREAU OF LAND MANAGEMENT

BOUNDARY SPRING

DESIGNED FO

RECOMM. _____

DRAWN FO

RECOMM. _____

CHIEF, DIV. OF ENO.

CHECKED _____

APPROVED _____

SCALE 4" = MILE

DATE 9-12-84

SHEET 1 OF 1

DRAWING NO. _____

★ GPO — 679-380