



RECEIVED

JUN 06 2000

FINAL PROOF SURVEY MAP

Prepared by: John D. Martin
437 WRE

WATER RESOURCES DEPT.
SALEM, OREGON

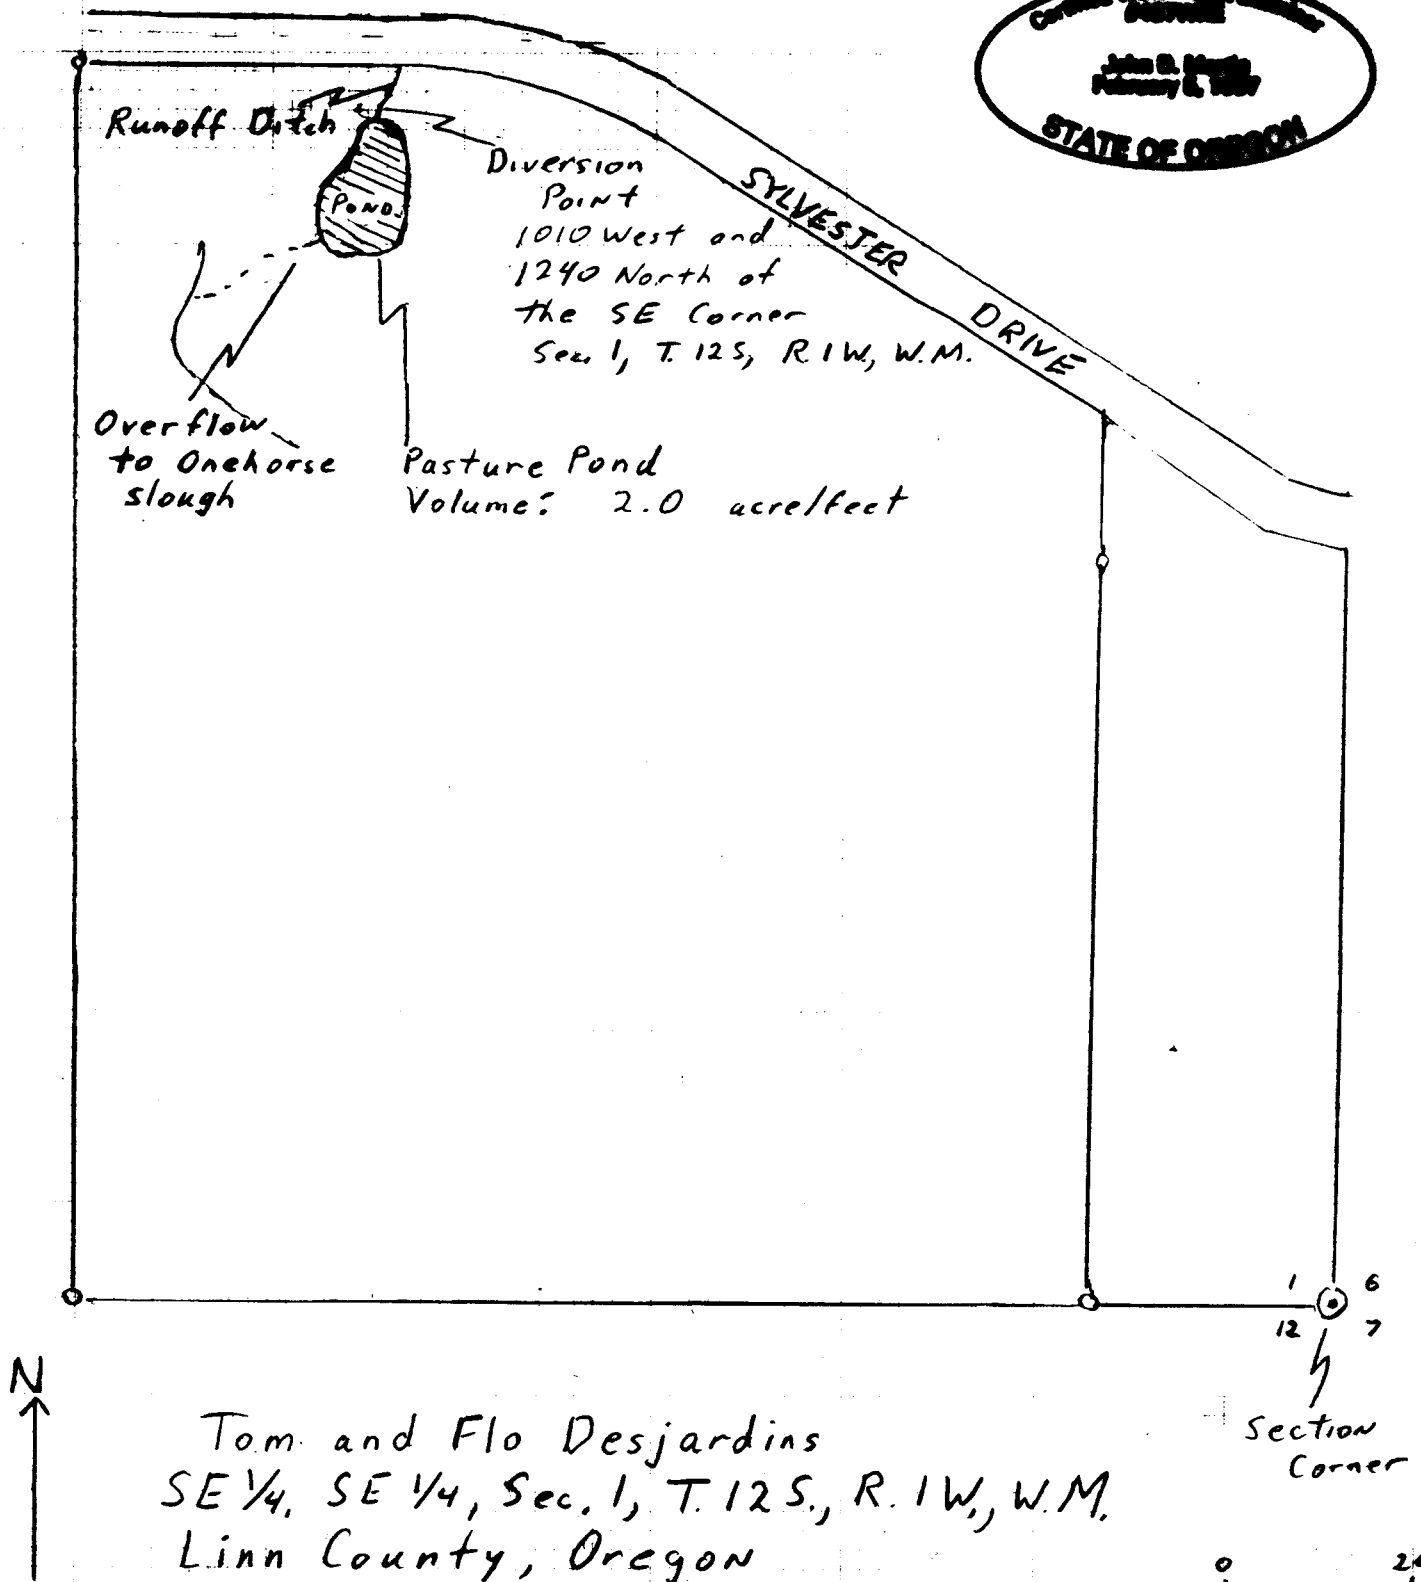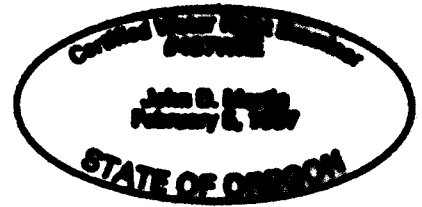

Tom and Flo Desjardins
SE $\frac{1}{4}$, SE $\frac{1}{4}$, Sec. 1, T. 12S., R. 1W., W.M.
Linn County, Oregon
SEE Assessors Map 12S-1W-01
and 8/11/98 Aerial Photo

0 200'
Scale 1" = 200'