

RECEIVED

NOV 01 1994


RECEIVED

MAR 14 1995

DEPT. OF REVENUE
STATE OF OREGON

*Pond is located
at "orange dot"*


SCALE 1:48000

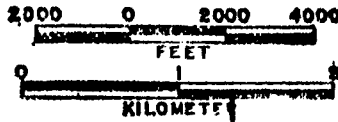

RECEIVED

JAN 12 1996

WATER RESOURCES DEPT.
SALEM, OREGON

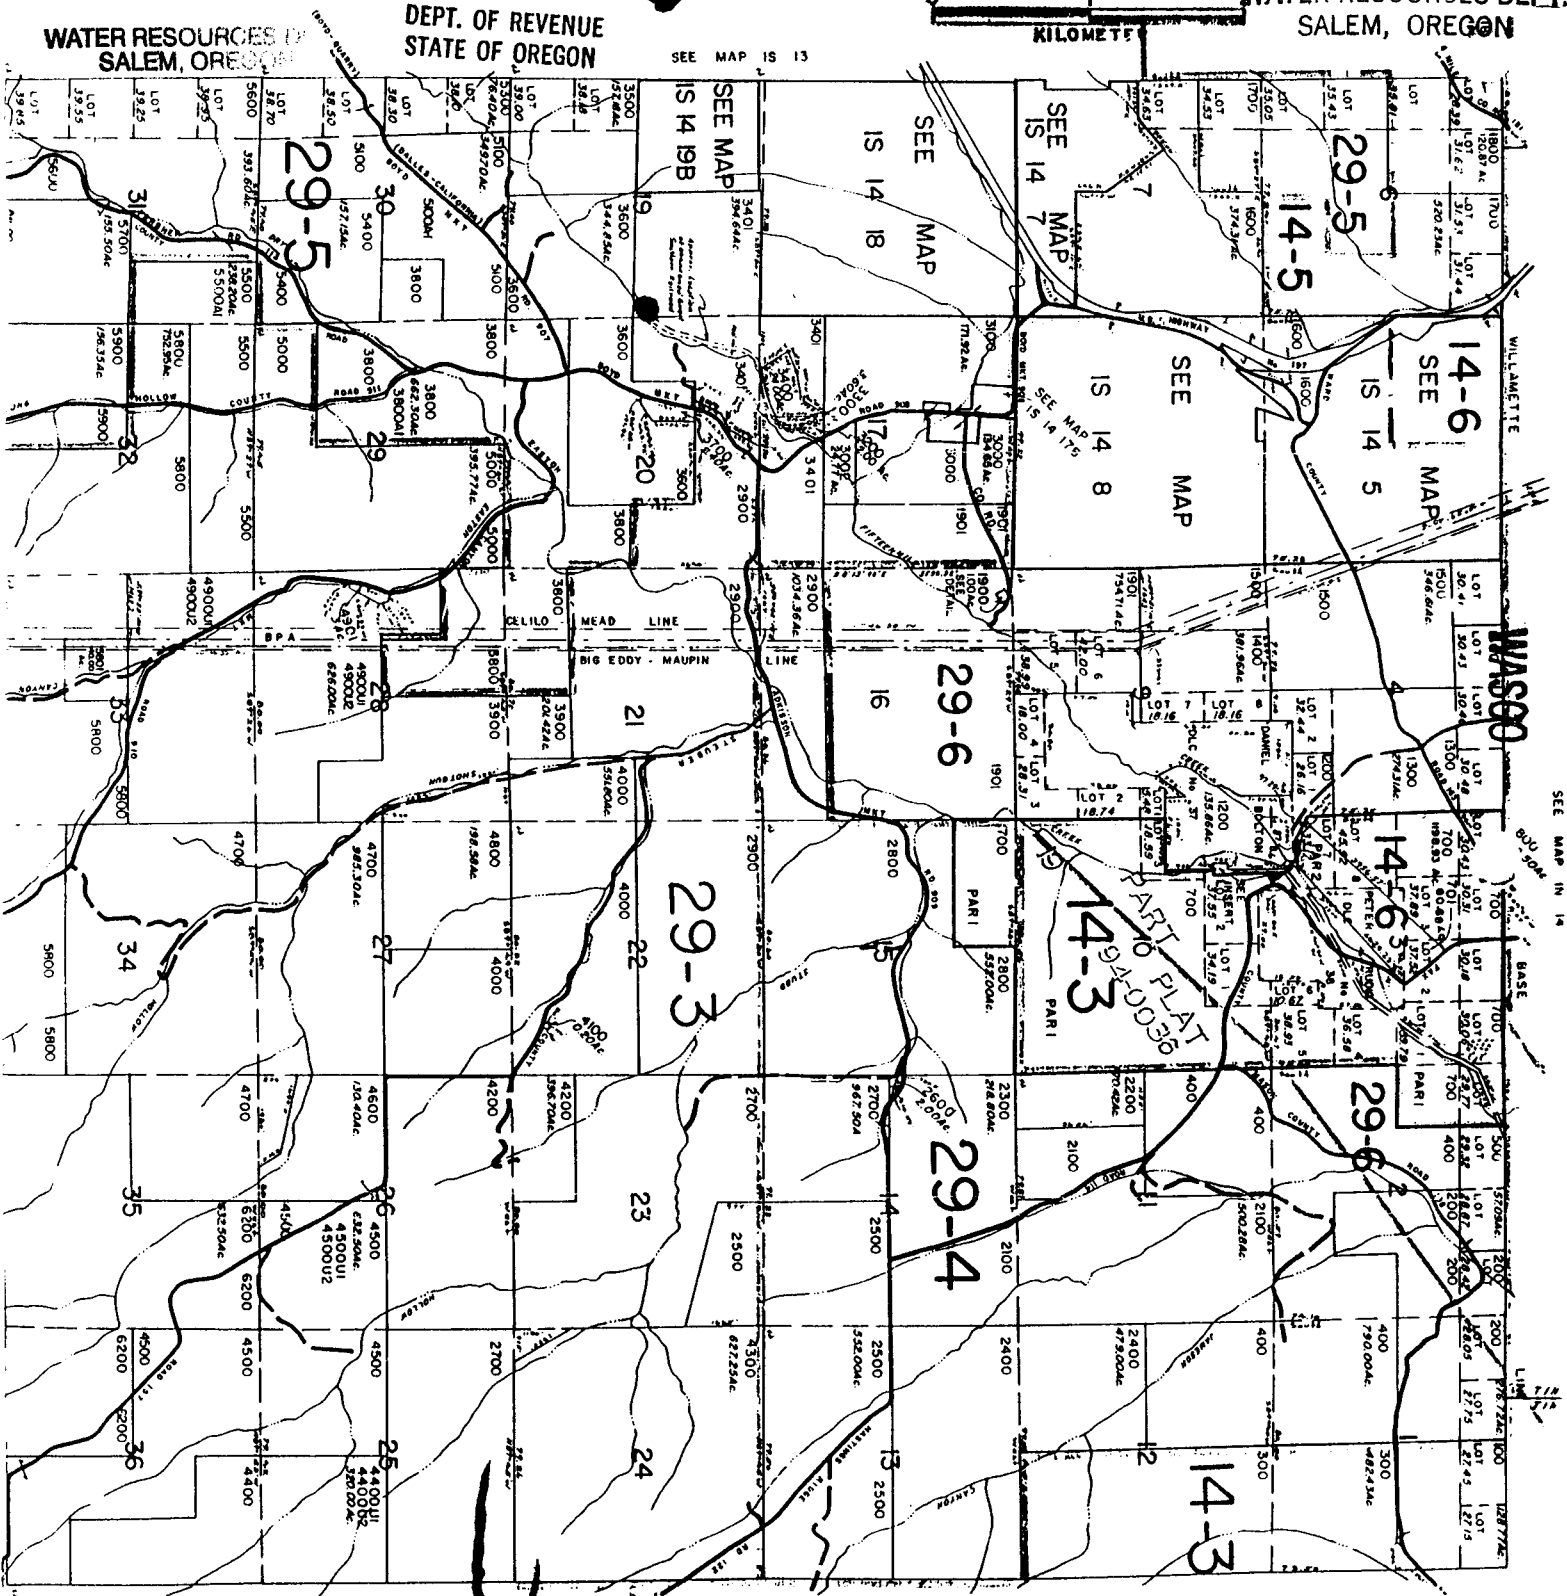

SEE MAP IS 13

SEE MAP IS 15


Application No. R-80834
Permit No. R11941

SEC 3 & 10 INSERT
600

14
LED NR