


SECTION

30 NESE

TOWNSHIP 16S, RANGE 27E, W. M.

North

#3245 - Ellingwood C

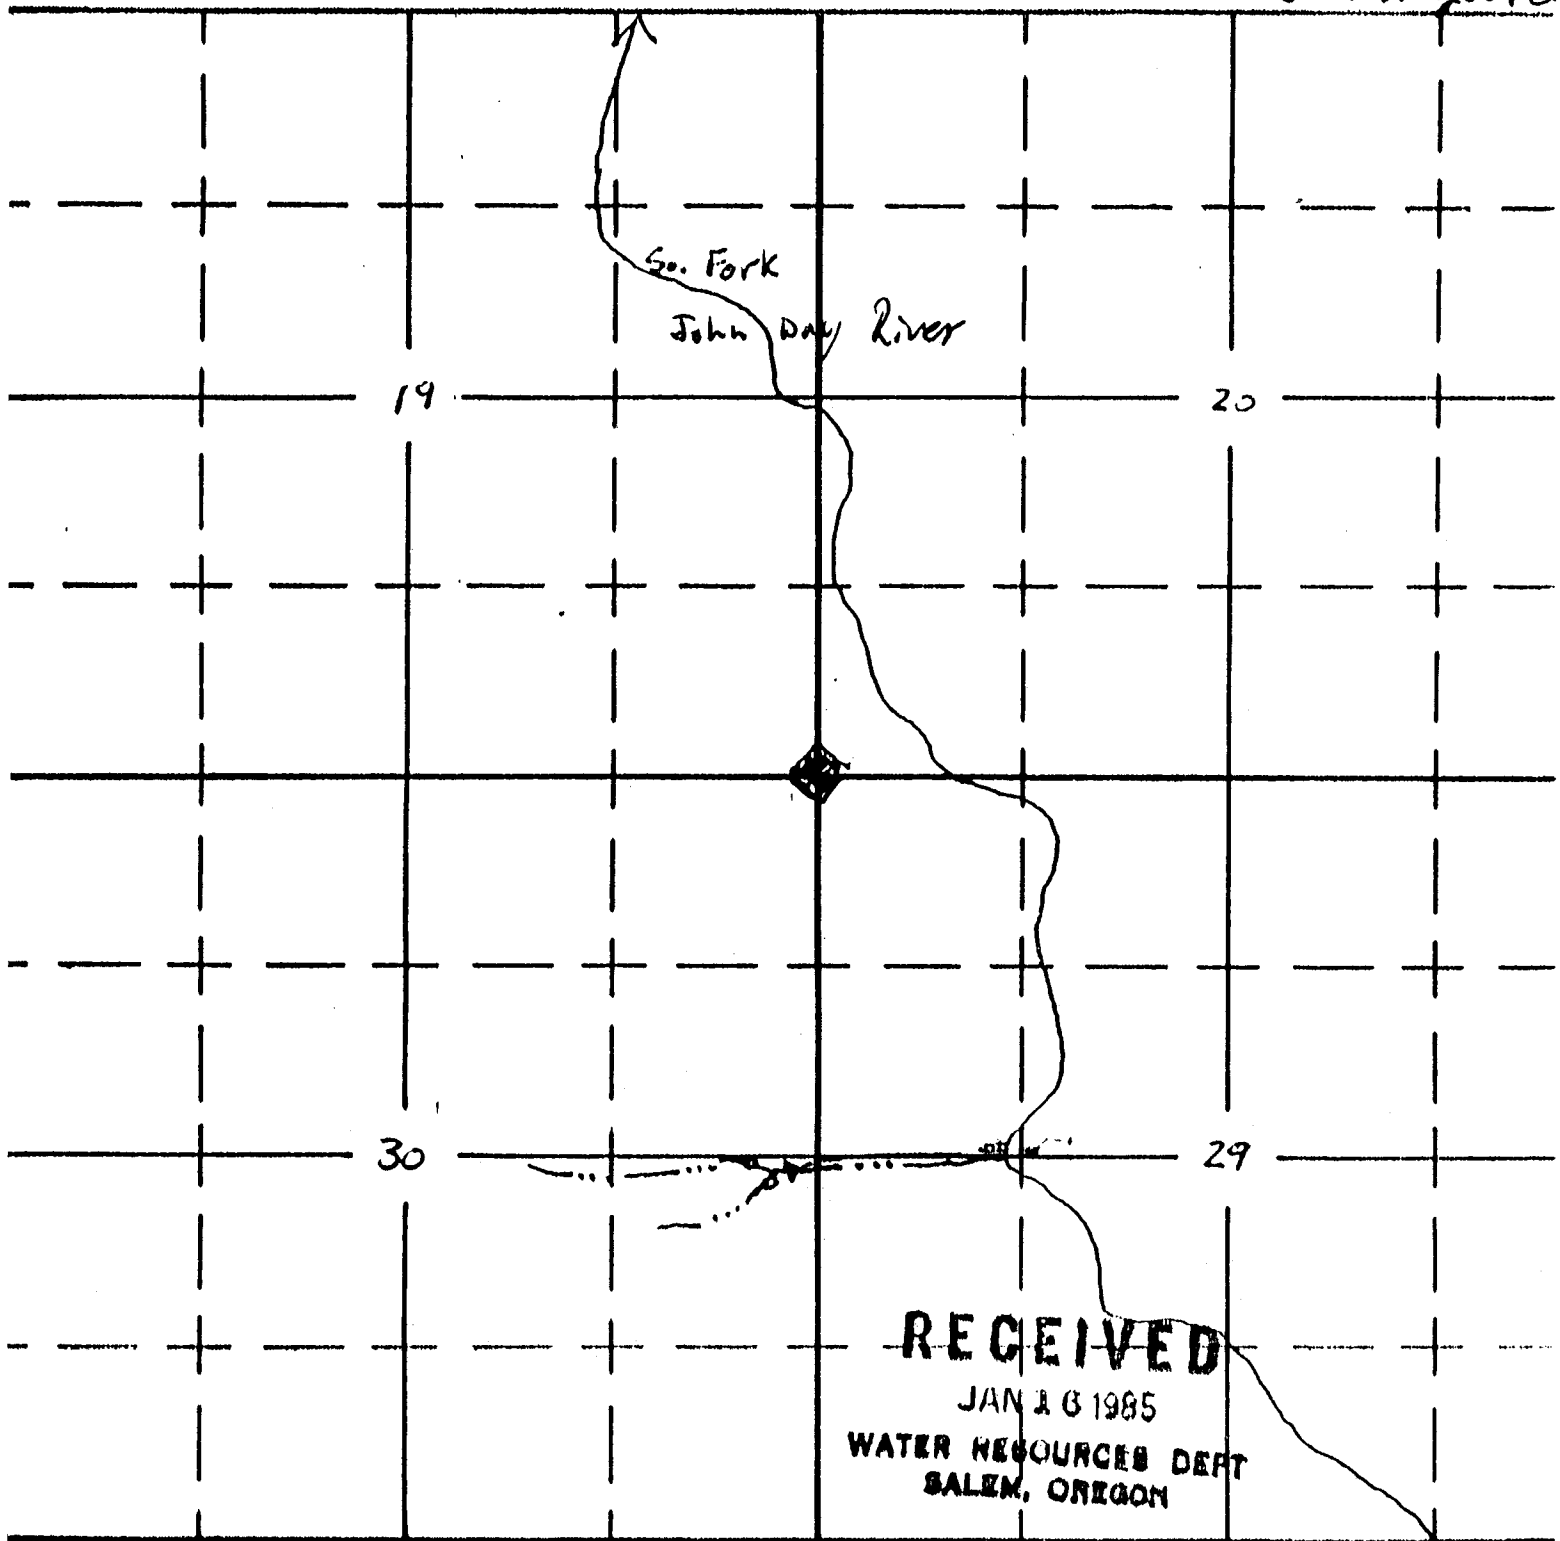

South

Application No. 66522
Permit No. 51420

RECEIVED
JAN 16 1985
WATER RESOURCES DEPT
SALEM, OREGON

RECEIVED
SEP 21 1983
WATER RESOURCES DEPT.
SALEM, OREGON