


T. 34 S., R. 1 W., W. M.

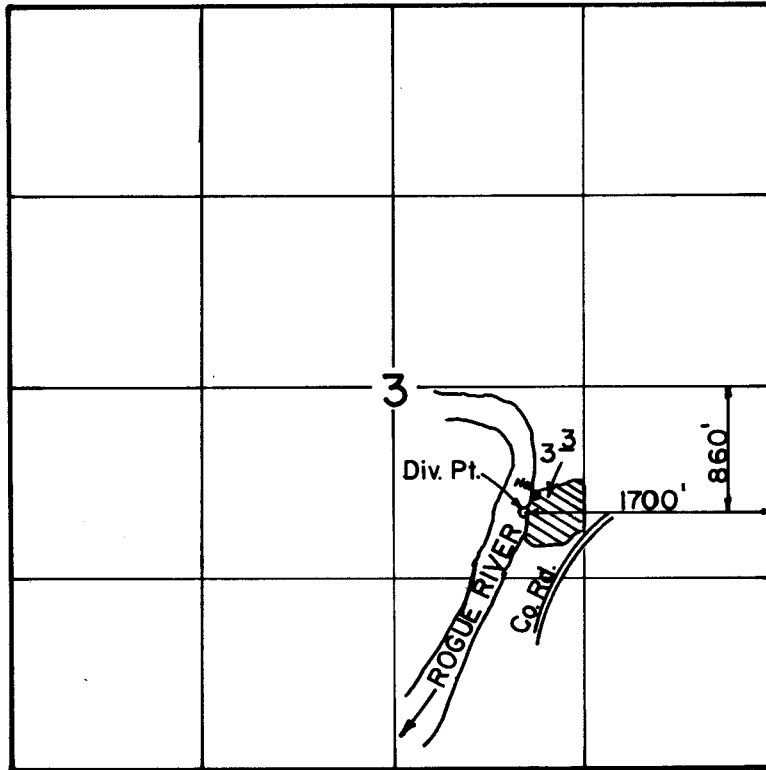

Scale: 1" = 1320'

FINAL PROOF SURVEY
UNDER

Application No. 68830 Permit No. 49937...
IN NAME OF

...DONALD... & ...INES... OYLER...

Surveyed AUG. 14. 1991., by B. S. JAMES...