


T. 29 S., R. 3 W., W.M.

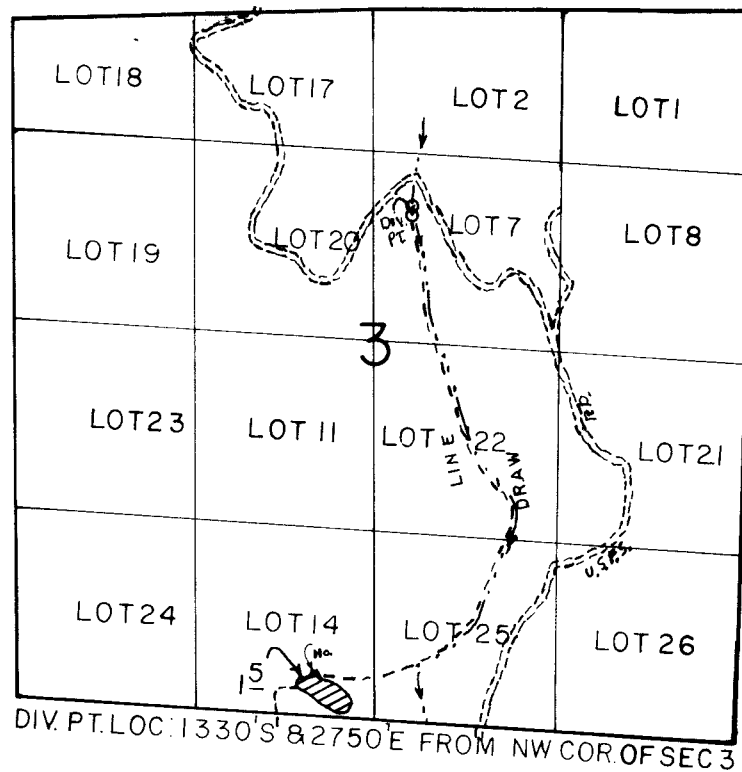

SCALE: 1"=1320'

FINAL PROOF SURVEY UNDER

Application No. 53656. Permit No. 40335.....
IN NAME OF

LYNDAL BLUMENTHAL & HELENE GWYNN

Surveyed JULY 9, 1997, by R.M. SUTTERFIELD