
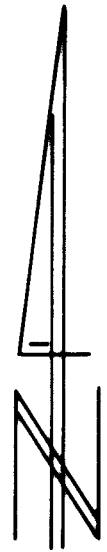


T. 2 S., R. 6 E., W.M.

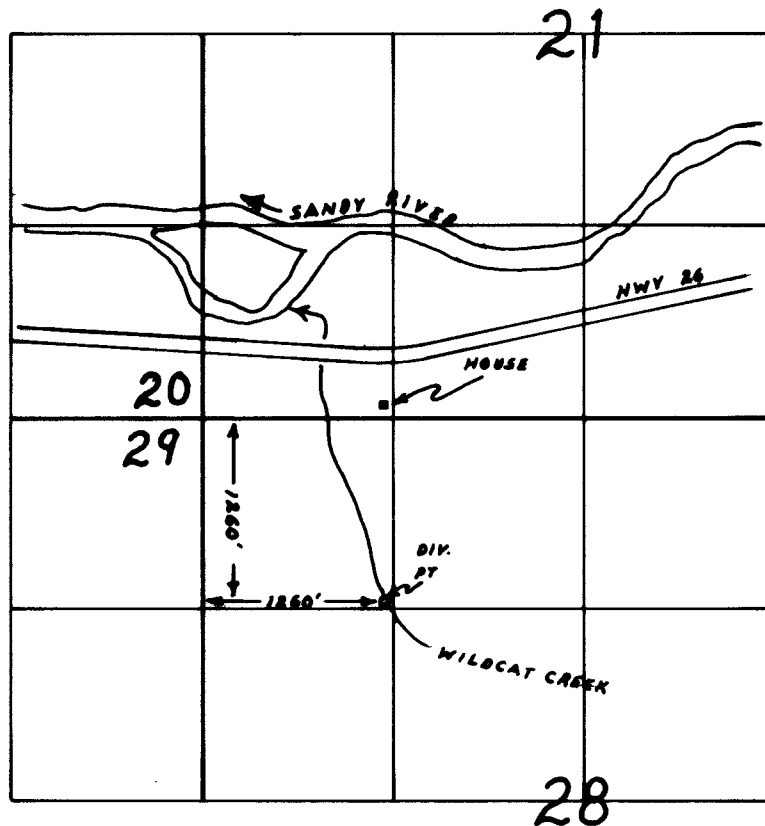

1" = 1320'

FINAL PROOF SURVEY

UNDER

Application No. 55352 Permit No. 41561

IN NAME OF

Cecil O. Viles

Surveyed August 31, 1993, by R.W. Klassen