
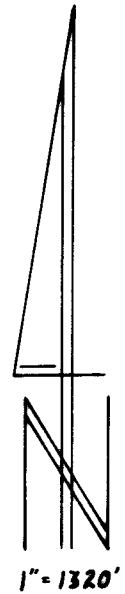


T. 15 S., R. 9 W., W.M.

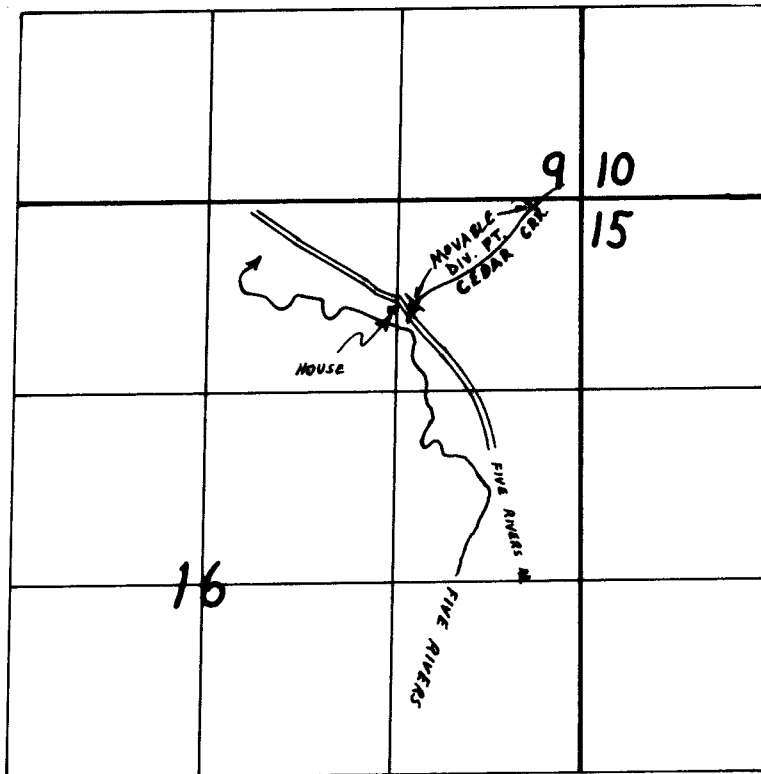

MOVABLE POINT OF DIVERSION BETWEEN:
UPPER LIMIT: 70' SOUTH AND 360' WEST } BOTH FROM NE CORNER,
LOWER LIMIT: 740' SOUTH AND 1160' WEST } SECTION 16

FINAL PROOF SURVEY

UNDER

Application No. 55984 Permit No. 42748

IN NAME OF

EULDEAN MCDANIEL

Surveyed NOVEMBER 16, 1992, by R.W. Klassen