


# T2S, R3E, WM

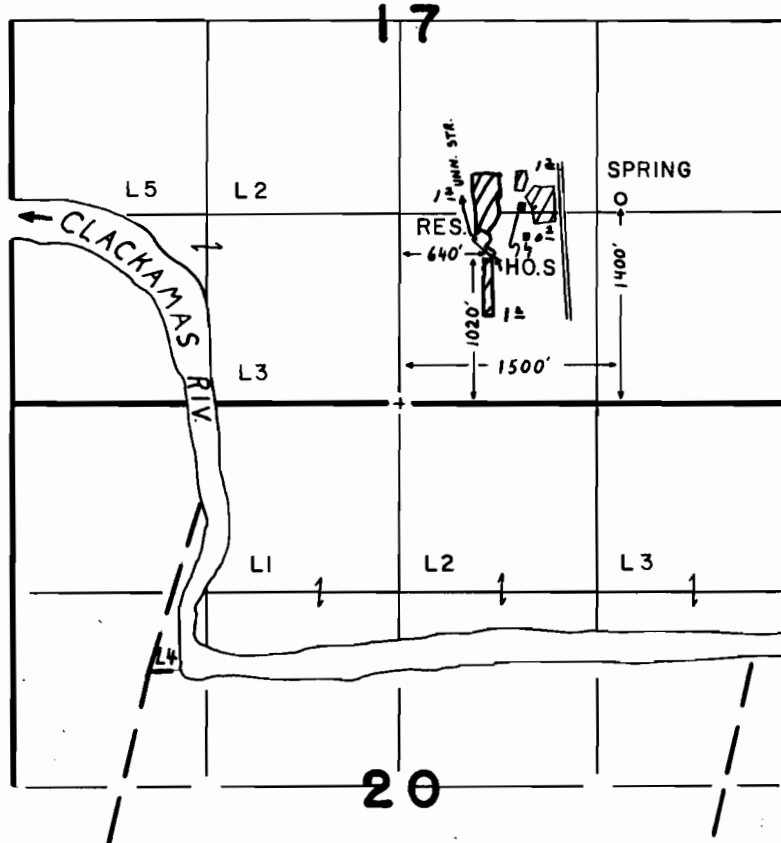

## FINAL PROOF SURVEY UNDER

R-58668                      R-8278  
 Application No. ~~58669~~ Permit No. ~~45852~~...  
 IN NAME OF

.....WADE NEWBIGIN JR.....

Surveyed AUG. 26, 1987., by J.M. WARREN...