


T2S, R3E, WM

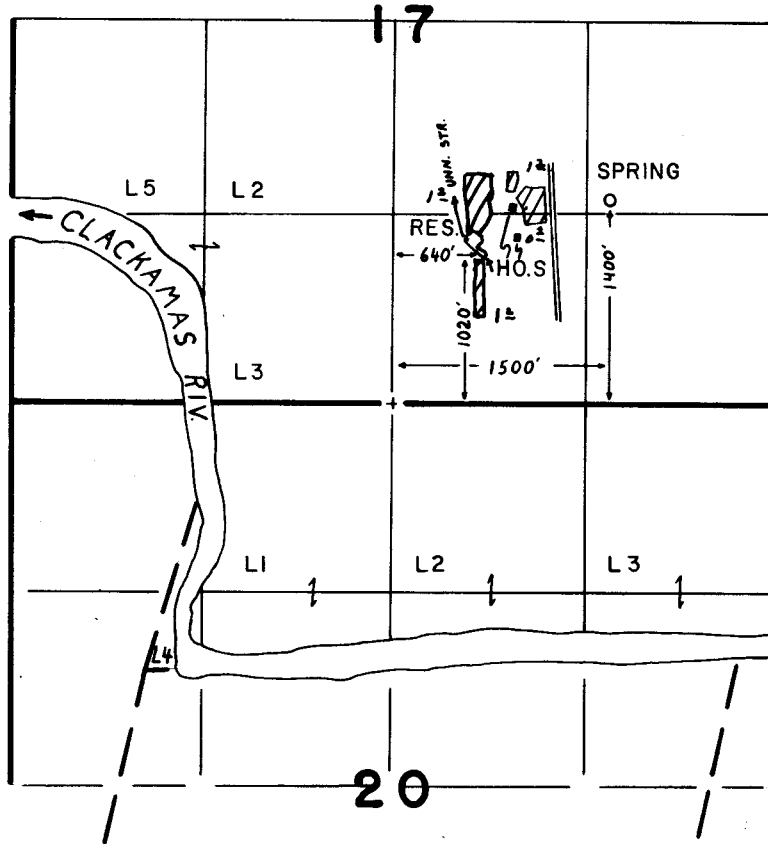

FINAL PROOF SURVEY UNDER

R-58668 R-8.278
 Application No. 58669 Permit No. 45852...
 IN NAME OF

WADE NEWBIGIN JR.

Surveyed AUG. 26. 1987., by J. M. WARREN.