


T. 6 S., R. 11 W., W.M.

Sec. 23

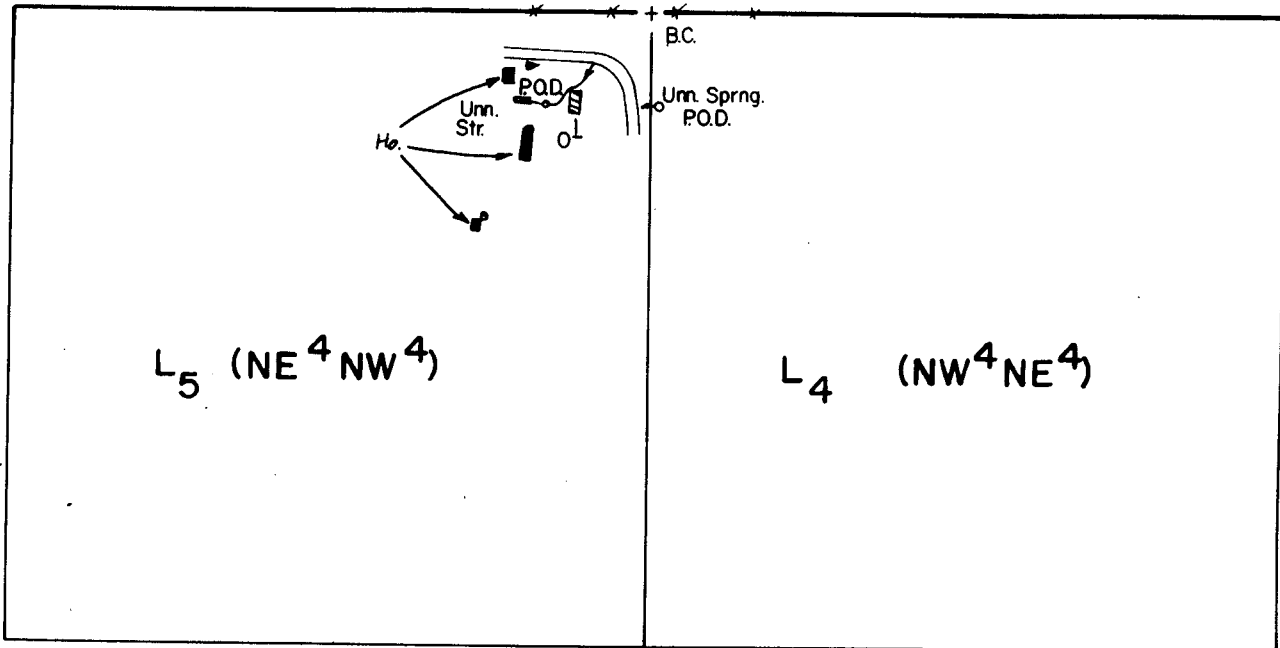

Spring P.O.D. Loc.: 195' S. & 20' E.
Stream P.O.D. Loc.: 190' S. & 220' W.
both from N. 1/4 Cor. Sec. 23.

Spring Use (domestic) - ■
Stream Use (irrigation) - ▨

Scale: 1" = 400'

FINAL PROOF SURVEY
UNDER

Application No. 6372!.... Permit No. 47257.....
IN NAME OF

MALCOLM J. & ELEANOR S. MONTAGUE

Surveyed JUNE 19, 1986, by T. Warren.....

PTS-1986-AA
3/6/87 TMW
4/15/2003 GBC