


# T. 14 S., R. 9 W., W.M.

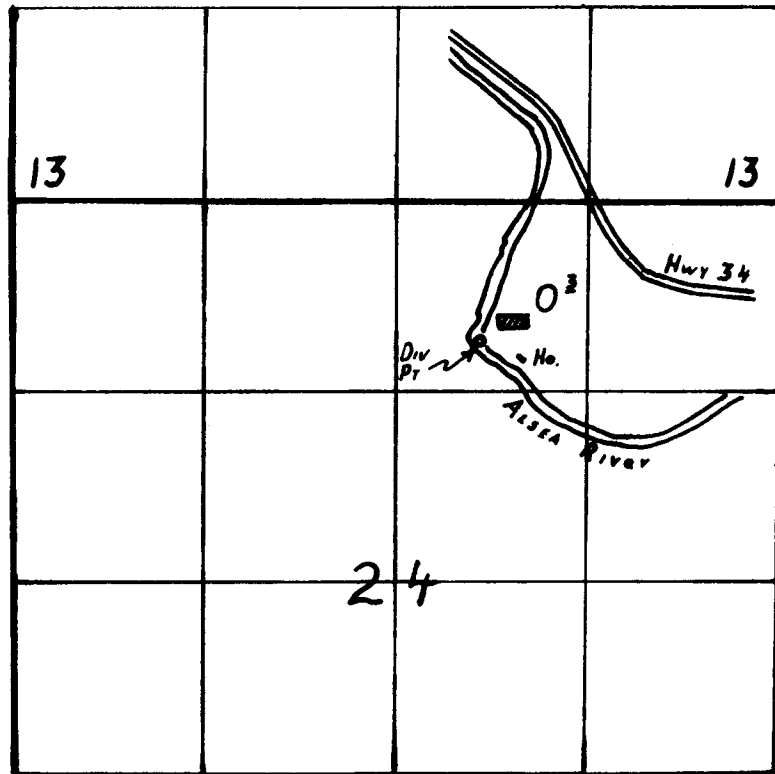

DIV PT LOCATED 950' S AND 500' E FROM THE N 1/4 CORNER

## FINAL PROOF SURVEY

UNDER

Application No. 68081 Permit No. 48516  
IN NAME OF

BURNETTE R. STAFFENSON

Surveyed AUGUST 7, 1992, by R.W.Klassen