
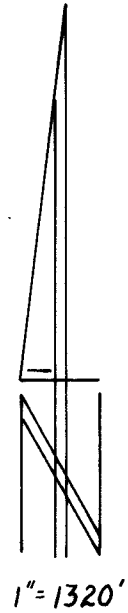


T. 1 S., R. 5 W., W.M.

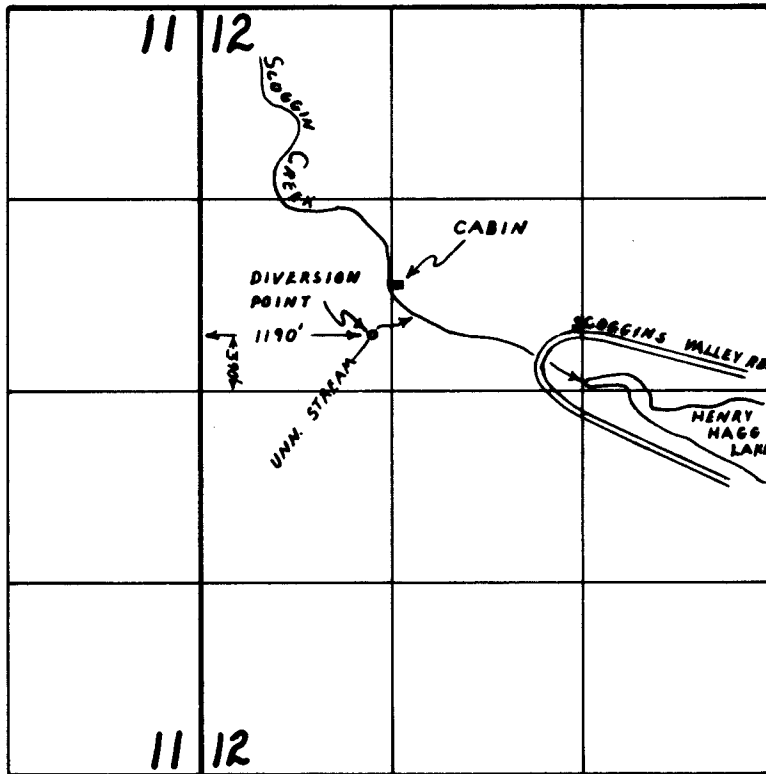

FINAL PROOF SURVEY

UNDER

Application No. 68237 Permit No. 49177

IN NAME OF

WILLIAM G. PITMAN

Surveyed July 14, 1993, by R.W. Klassen