


T. 12 S., R. 6 W., W.M.

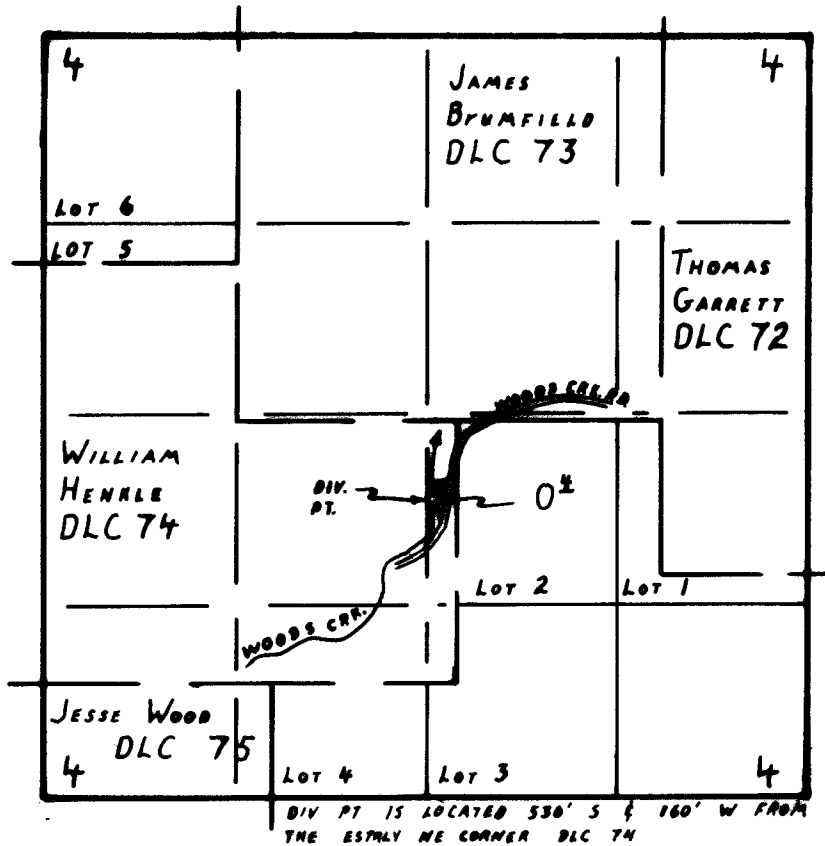

FINAL PROOF SURVEY

UNDER

Application No. 68609 Permit No. 49684
IN NAME OF

Donald K. and Eileen M. Bisson

Surveyed March 8, 1991, by Russell W. Klassen