


# T. 2 S., R. 3 W., W.M.

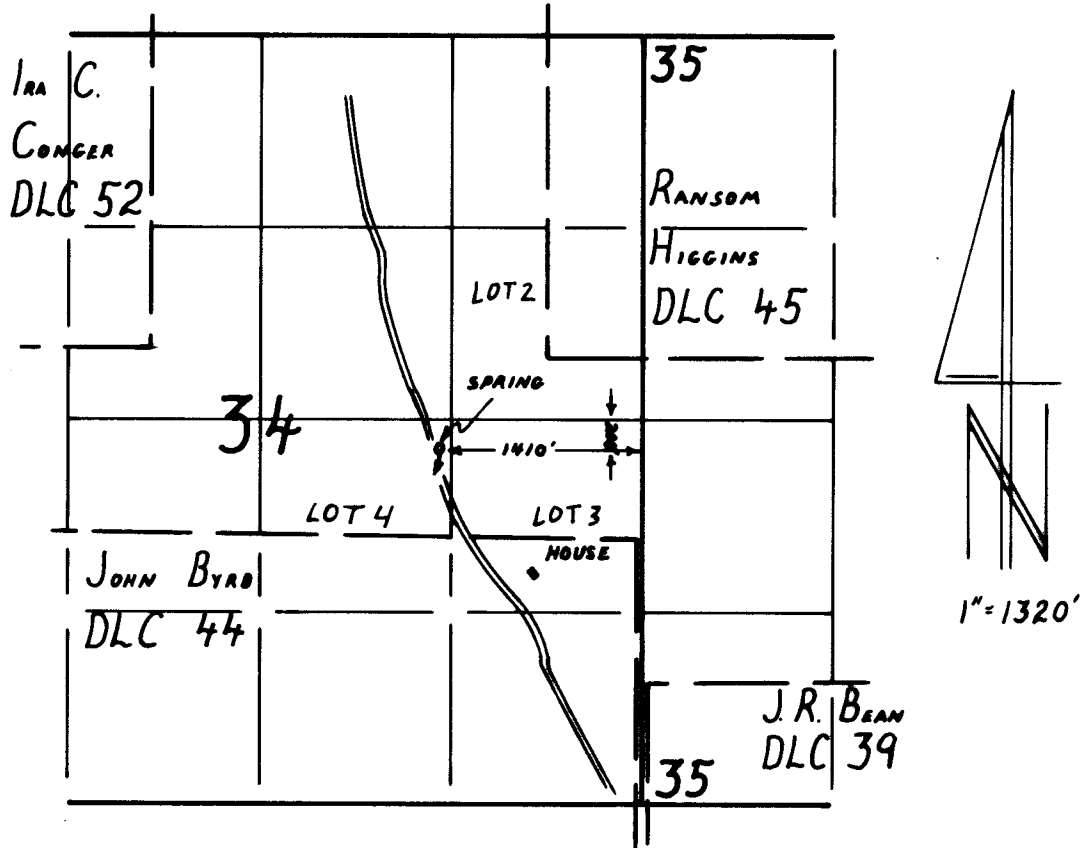

## FINAL PROOF SURVEY

UNDER

Application No. 68754 Permit No. 49827

IN NAME OF

Joseph Longo

~~HARRY A. & MABEL WALTERS~~

Surveyed FEBRUARY 28, 1991, by R.W. Klassen