


T. 26 S., R. 13 W., W.M.

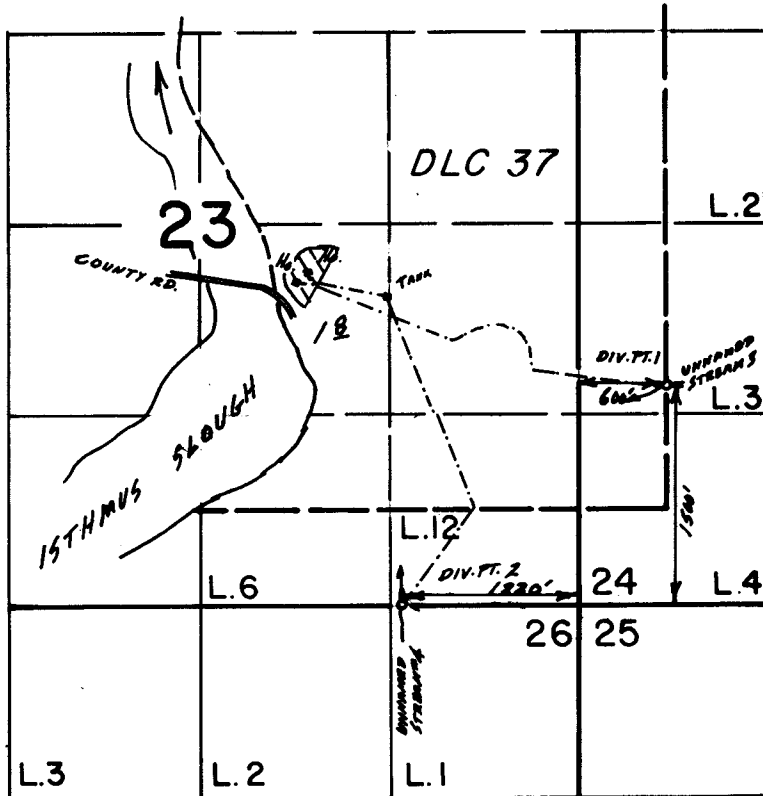

Scale : 1" = 1320'

**FINAL PROOF SURVEY
UNDER**

Application No. 69037 Permit No. 50008...
IN NAME OF

.....BARBARA.....A.....LYONS.....

Surveyed Sept. 19, 1988, by J. KAUPPILA
Sept. 17, 1990, by B. BISHOP